


T. 2 S., R. 2 E., W.M.

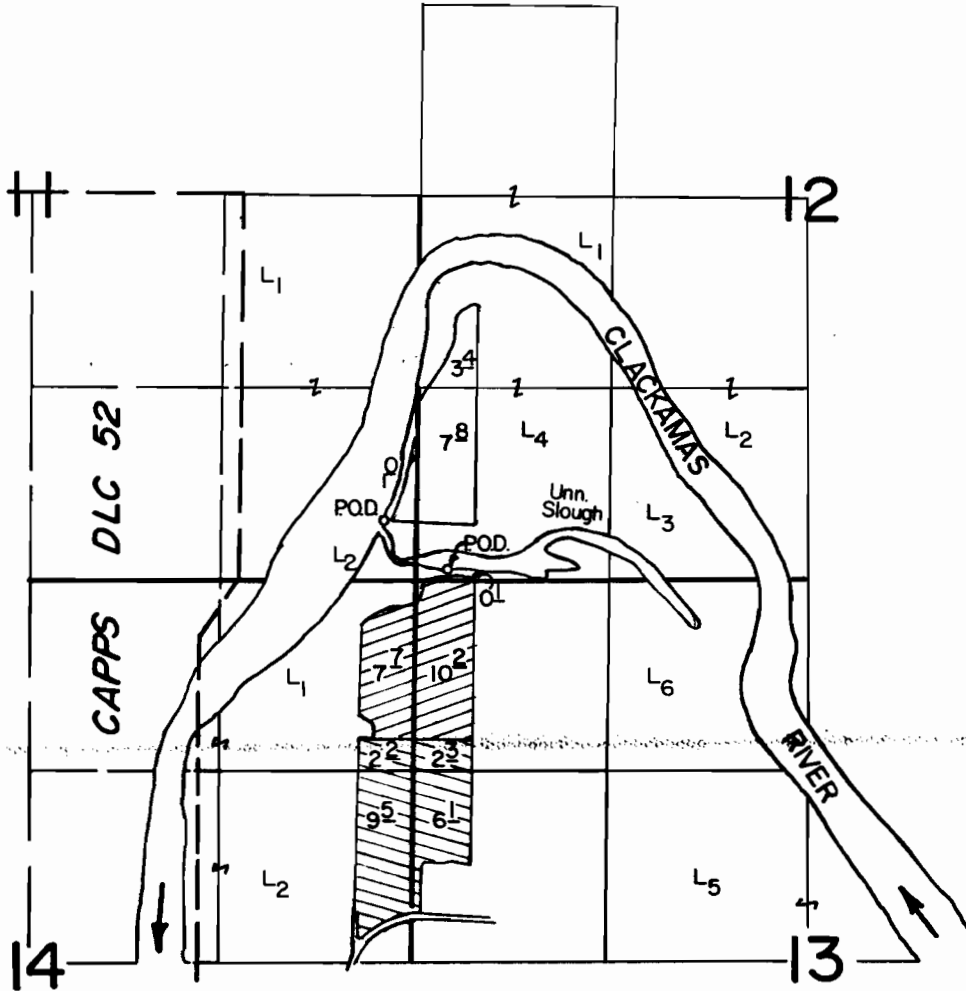

River P.O.D. Loc.: 400' N. & 220' W.
 Slough P.O.D. Loc: 70' N. & 210' E., both from SW Cor. Sec. 12.

FINAL PROOF SURVEY
 UNDER

56244 42248
 Application No. 58216... Permit No. 43816.....



Primary from Slough
 Supplemental from Slough

IN NAME OF

JAMES E. CALCAGNO

Surveyed AUG. 25. 1986, by T. Warren.....

41005-278-97 R
 2/17/87 TMW