


T. 4 S., R. 1 W., W.M.

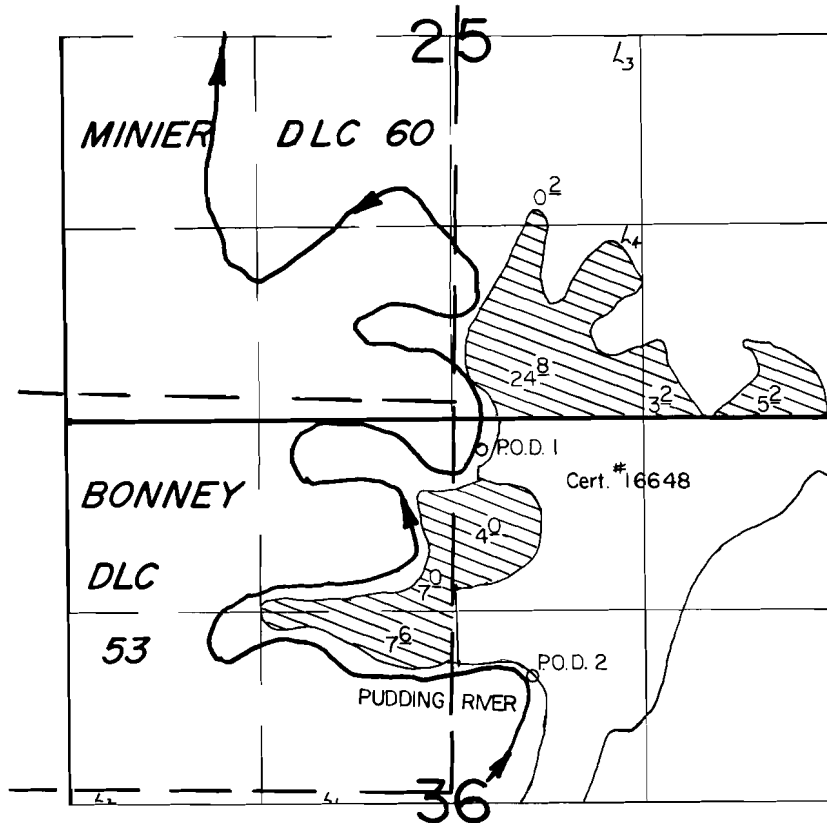

P.O.D. 1 Loc. : 210' S. & 190' E.
 P.O.D. 2 Loc. : 1780' S. & 550' E., both loc. from N. 1/4 Cor. Sec. 36.

Scale : 1" = 1320'

FINAL PROOF SURVEY
 UNDER

Application No. 58259... Permit No. 43868.....

IN NAME OF

LYNDA E. STROM

Surveyed JULY...3... 1985., by J. Warren.....