


T. 1 S., R. 3 & 4 W., W.M.

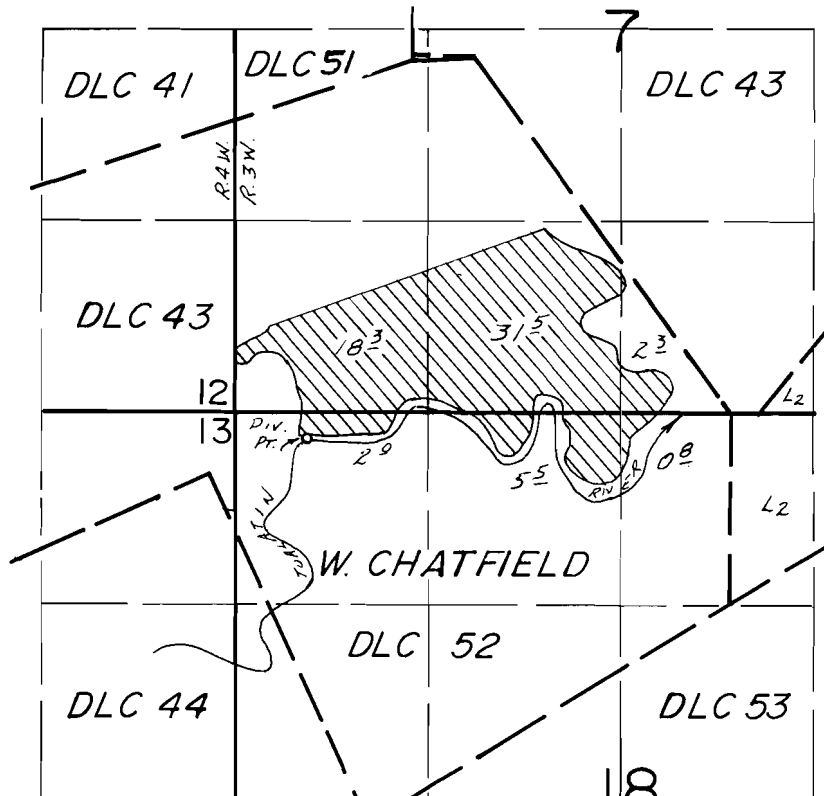

DIV. PT. LOC.: 170'S. & 490'E FROM NW COR. SEC. 18

SCALE: 1" = 1320'

FINAL PROOF SURVEY
UNDER

Application No. 58309.. Permit No. 43866.....

IN NAME OF

.....EUGENE VANDEHEY.....

Surveyed Aug. 14.. 19.86, by B.W. BISHOP.....

4/9/87 GUB

41067-178-107L