


T.37S., R.14&15W., W.M.

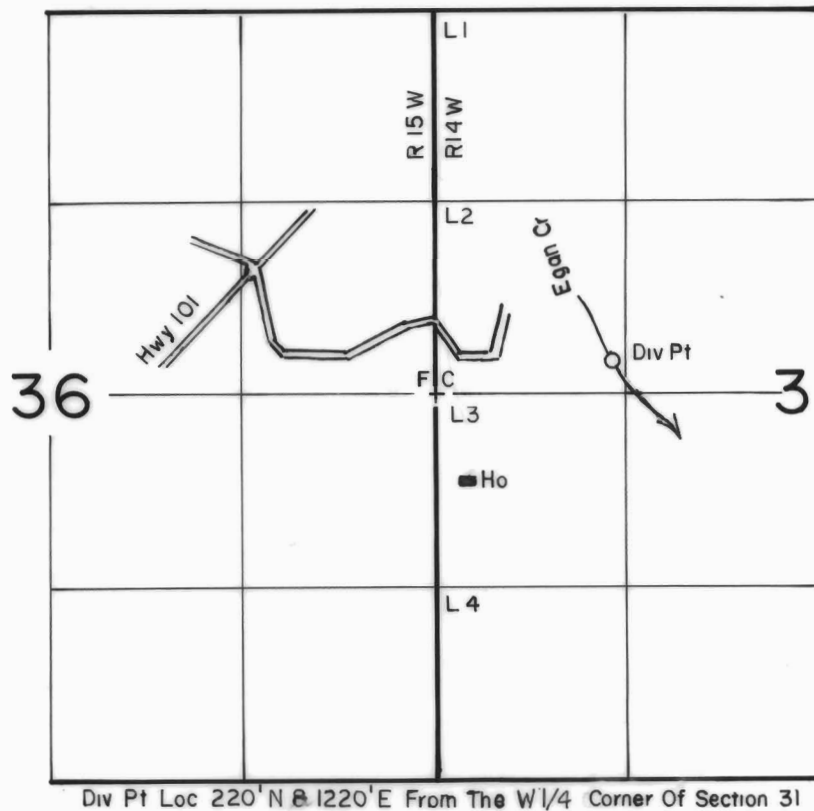

SCALE: 1"=1320'

FINAL PROOF SURVEY
UNDER

Application No. 58332.. Permit No. 43940.....
IN NAME OF

JACK S. & HELEN P. CARICHOFF.....

Surveyed JULY..28.. 1989., by B.S.JAMES.....