


# T.5S., R.1W., W.M.

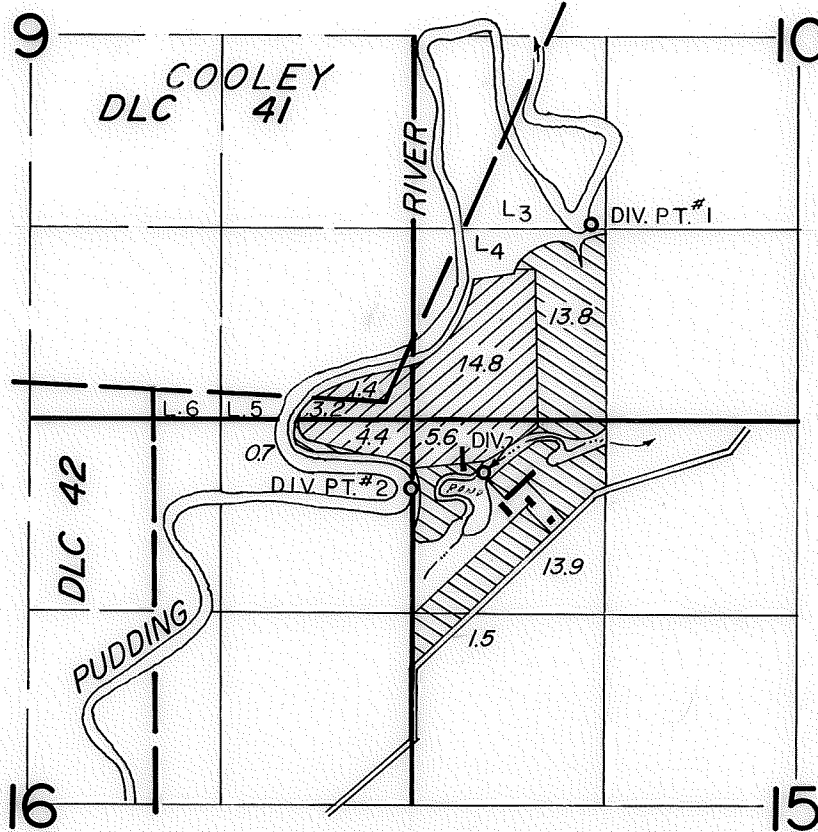

SCALE: 1"=1320'

DIV. PTS. LOC.: #1-1350'N. & 1200'E., #2-460'S. & 10'W., POND-350'S. & 480'E., ALL FROM NW COR. SEC. 15.

- Primary from river, supplemental from pond
- Supplemental from pond

## FINAL PROOF SURVEY UNDER

Application No. 58365 Permit No. 43965

IN NAME OF

**CORDELL TITTLE**

Surveyed AUG. 29, 1979, by *d. Brown*

REVISED 10/27/86 BMB