


T. 3 S., R. 1 W., W. M.

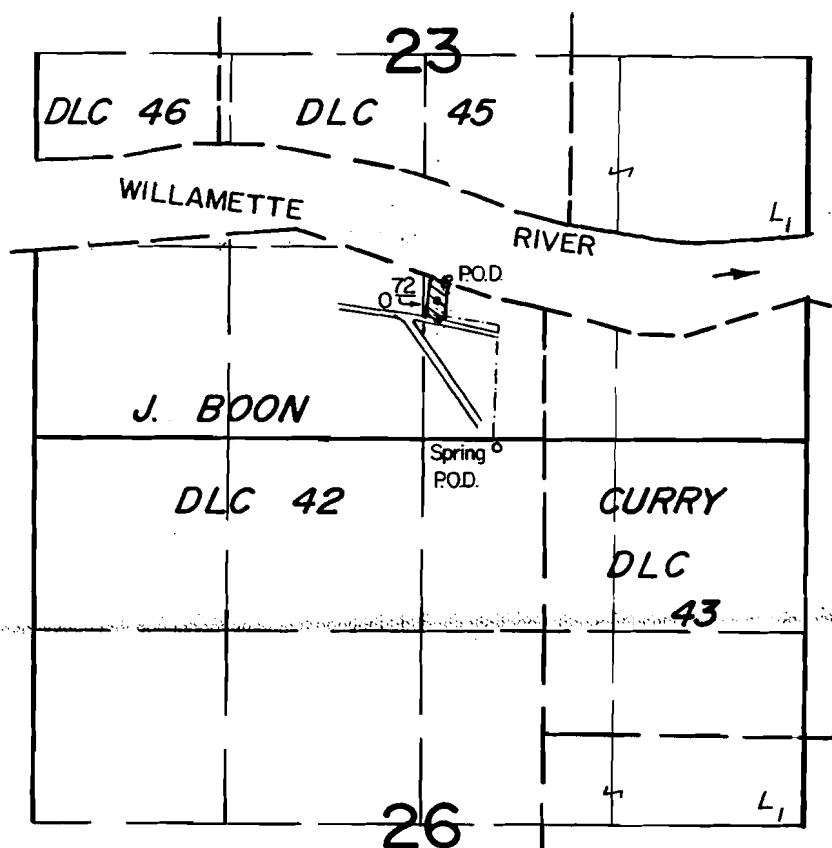

River P.O.D. Loc.: 210' N. & 650' W.

Spring P.O.D. Loc.: 300' S. & 350' W., both from NE Cor. BOON DLC 42.

Scale: 1" = 1320'

FINAL PROOF SURVEY
UNDER

Application No. 58428 Permit No. 44038
IN NAME OF

FORREST G. MEGY

Surveyed JULY 17, 1986, by T. Warren

DFK-2LL-3
TMW 2/4/87