


T. 26S., R. 14W., W.M.

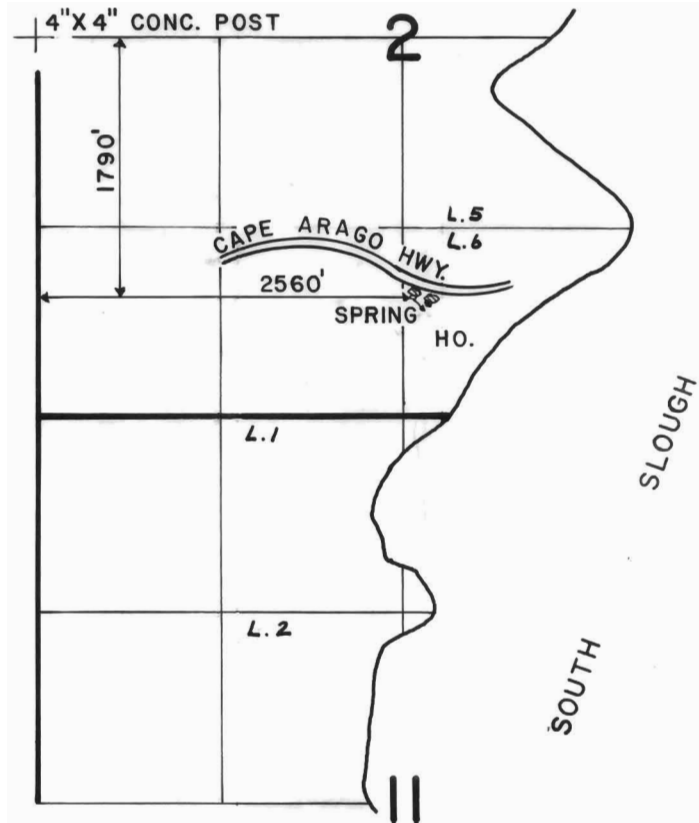

SCALE: 4" = 1 MILE

FINAL PROOF SURVEY UNDER

Application No. 58449 Permit No. 44079...
IN NAME OF

GLEN R. WOOD & MAXINE G. WOOD

Surveyed JULY 29, 1986, by J. M. SCHMORDE