


T. 25S., R. 6 W., W.M.
SECTION 33

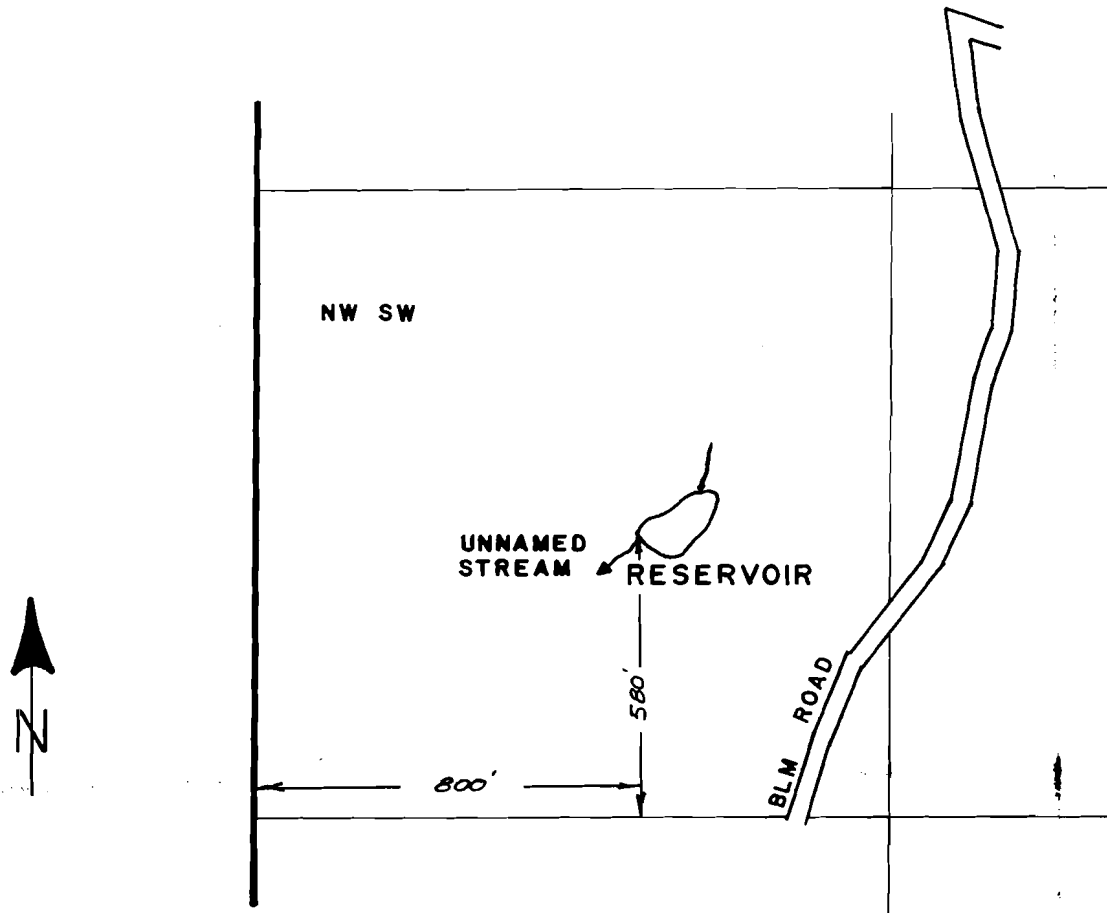

SCALE: 1" = 400'

FINAL PROOF SURVEY
UNDER

R-58489 R-7830
Application No. 58490 Permit No. 44175
IN NAME OF

LARRY BREWER

Surveyed JULY 15 1986, by J. M. SCHMORDE