


T.18S., R.46E., W.M.

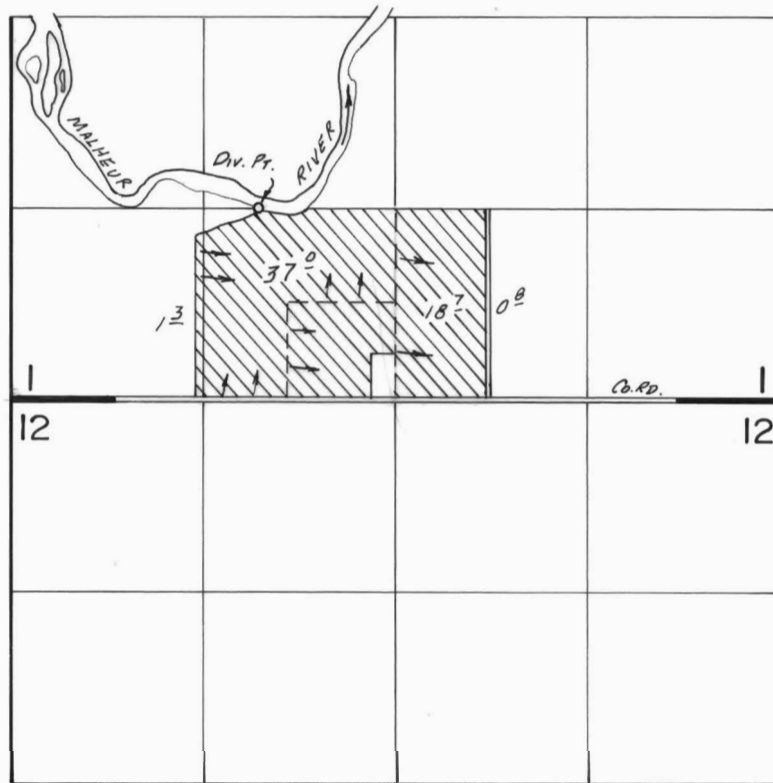

DIV. PT. LOC.: 1320' N. & 1700' E. FROM SW COR. SEC. 1

SCALE: 1" = 1320'

FINAL PROOF SURVEY UNDER

Application No. 58508.. Permit No. 44277.....
IN NAME OF

.....EDWARD P. & JANET A. STANTON

Surveyed ..Feb..2.... 1986, by L.M.TOLL.....