


T. 32 S., R. 16 E., W.M.

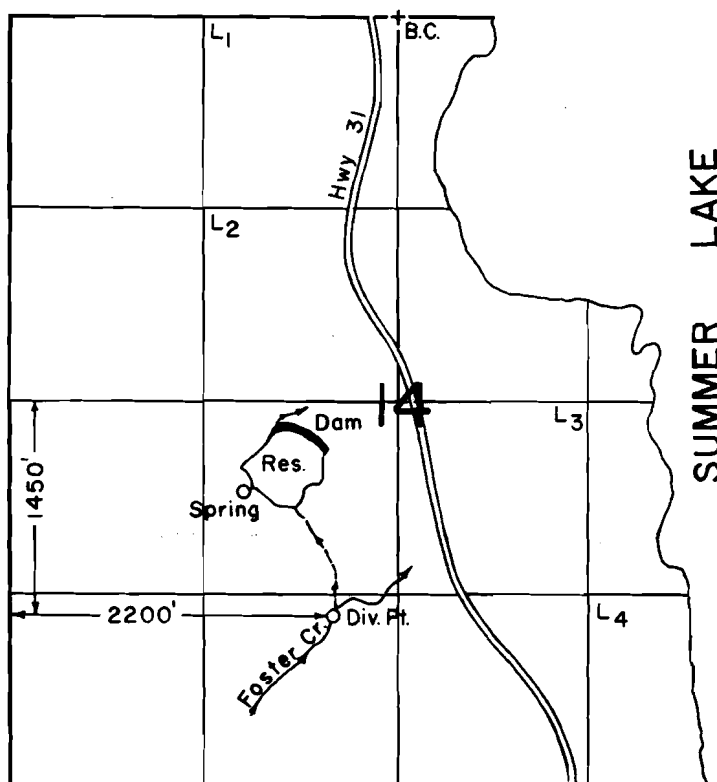

SCALE: 1" = 1320'

FINAL PROOF SURVEY

UNDER

Application No. R-58509 Permit No. R-8648....
IN NAME OF

.....WILLIAM W. SCHMIDT.....

Surveyed OCT. 16... 1985., by T. WARREN.....