


T. 34 S., R. 3 W., W. M.

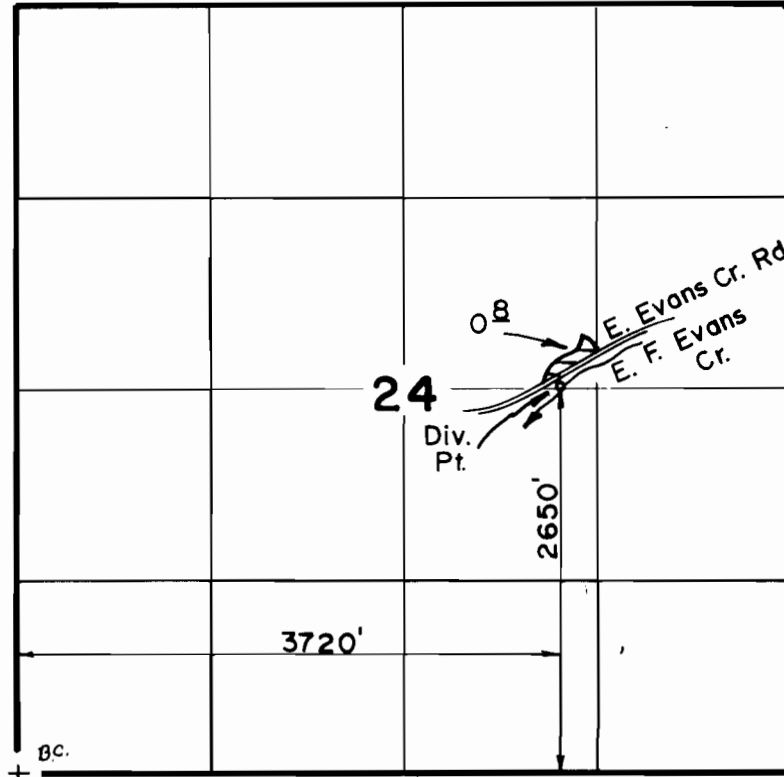

Scale: 1" = 1320'

**FINAL PROOF SURVEY**  
UNDER

Application No. 58554 Permit No. 44167  
IN NAME OF

OLIVE SPAUR

Surveyed JUL. 22. 1987. by B.S. JAMES