


T. 36 S., R. 5 W., W.M.

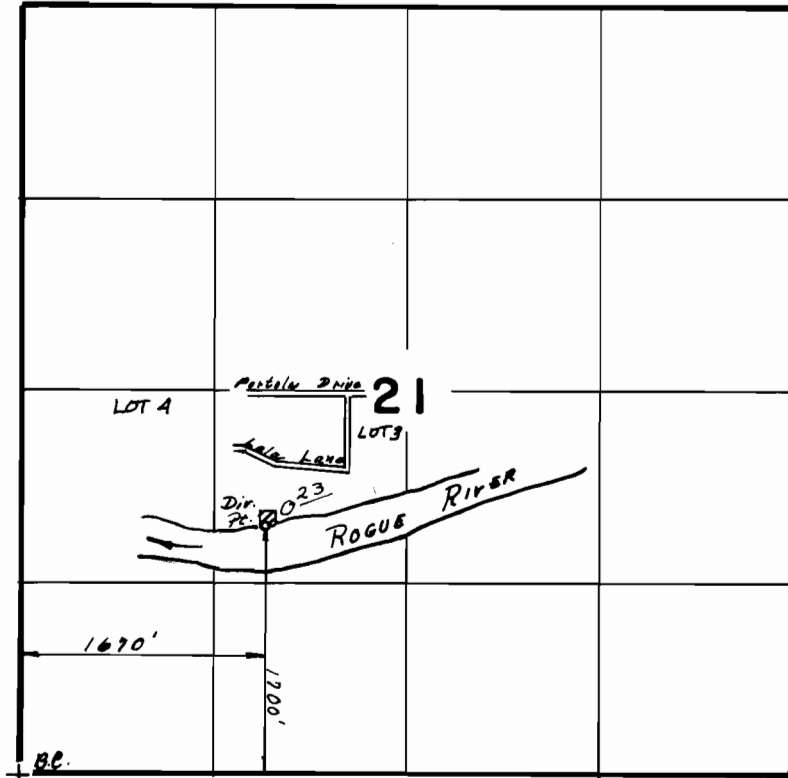

Scale: 1" = 1320'

FINAL PROOF SURVEY
UNDER

Application No. 58562 Permit No. 44625
IN NAME OF

OLIVER C. HARDY

Surveyed AUG. 3. 1987. by B. S. JAMES