


T. 34 S., R. 3 W., W. M.

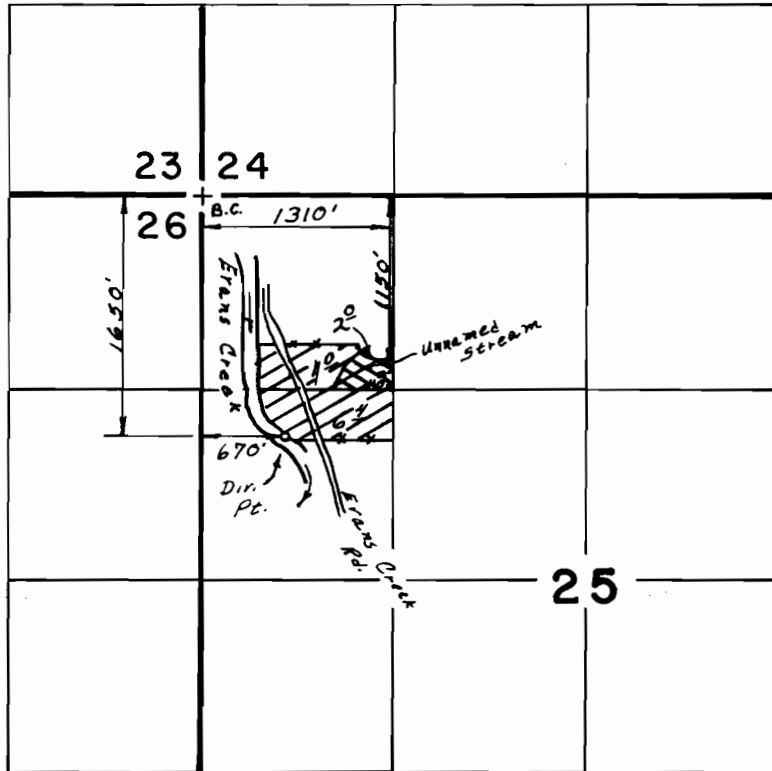

Scale: 1" = 1320'

FINAL PROOF SURVEY UNDER

58579	44124	
61703	45880	

Application No. Permit No.
IN NAME OF

ROBERT C. & PENNY J. GILKEY

Surveyed JUN...9.. 19.8.7, by B...S...JAMES...