


T.26S.,R.8W.,W.M.

Section I

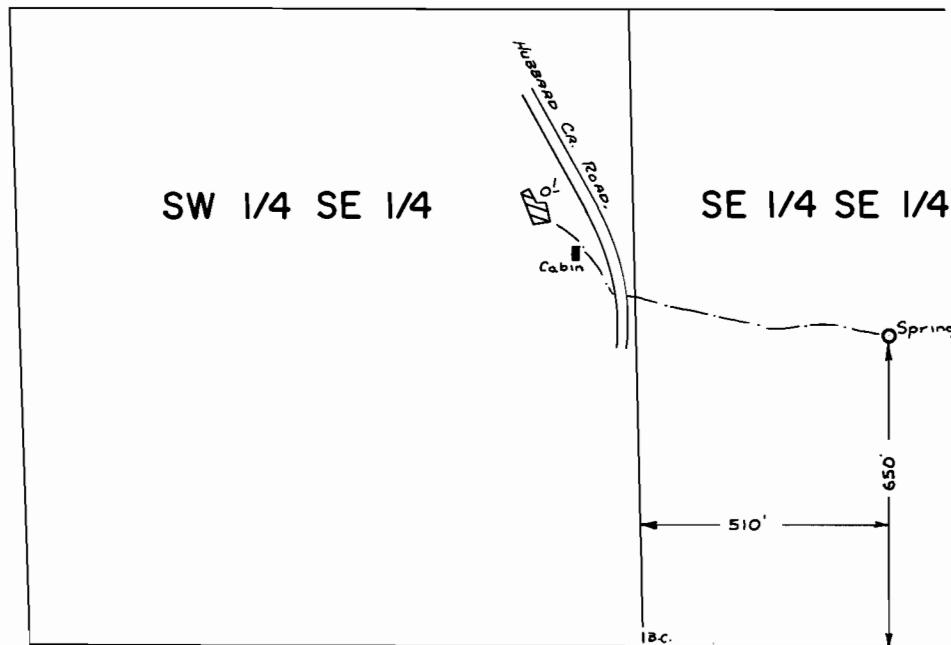

SCALE: 1" = 400'

FINAL PROOF SURVEY
UNDER

Application No. 50517 58596 Permit No. 38145 44240
IN NAME OF

RALPH & CATHY BURT, JR.

Surveyed June 22, 1982, by L. M. TOLL