


T. 27S., R. 3 W., W. M.

SECTIONS 14 & 23

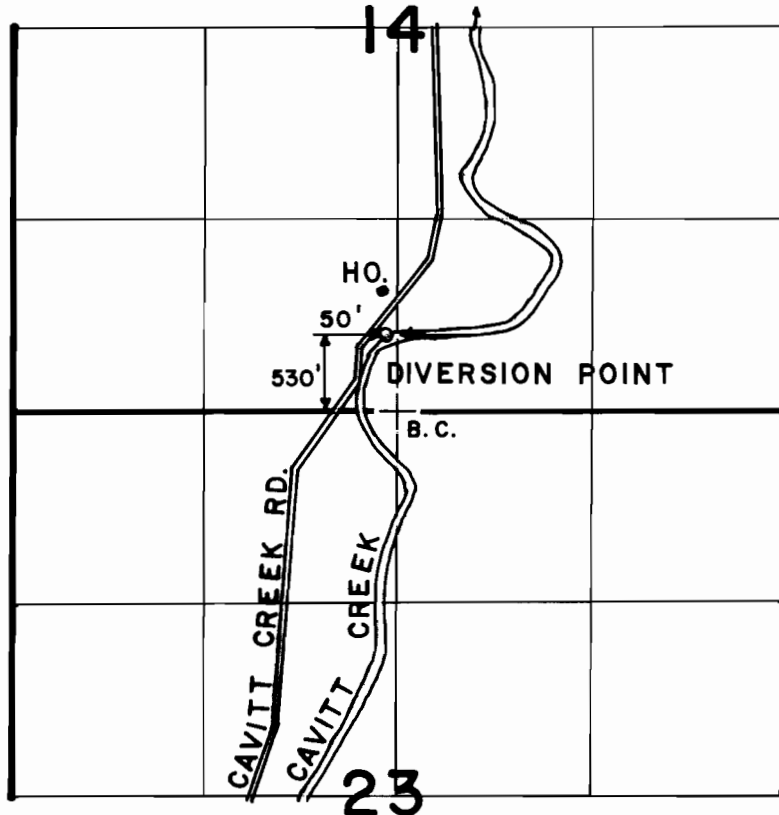

SCALE: 4" = 1 MILE

FINAL PROOF SURVEY
UNDER

Application No. 58623 Permit No. 44246
IN NAME OF

NOVA D. DIBALA

Surveyed JULY 18, 1984, by D. K. CLARK