


# T.3S.,R.1E.,W.M.

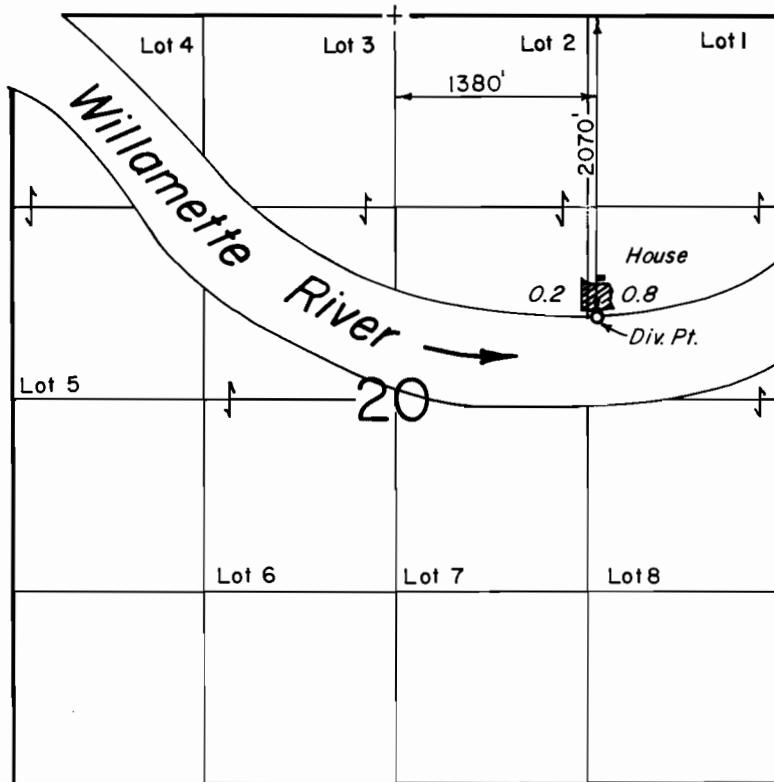

## FINAL PROOF SURVEY UNDER

Application No. 58751. Permit No. 44797.....

IN NAME OF

JOSEPH W. DAVIS

Surveyed AUG. 3, 1981, by *[Signature]*.....