


T. 4S., R. 3E., W. M.

Sec. 29

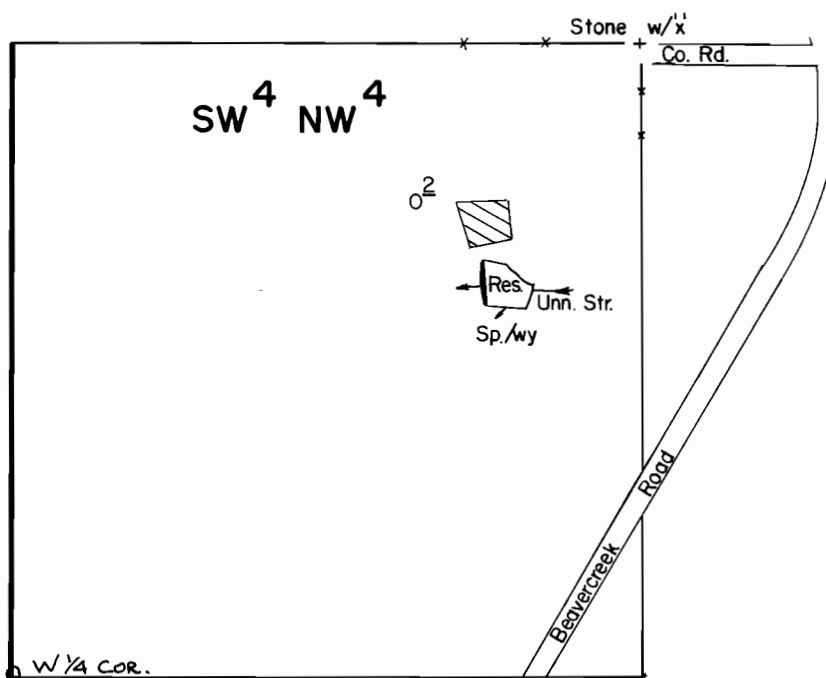

P.O.D. Loc.: 815' N. & 980' E. from W. 1/4 Cor. Sec. 29.

Scale: 1" = 400'

FINAL PROOF SURVEY

UNDER

R-59296

R-7957

Application No. 58753 Permit No. 44519

IN NAME OF

JAMES C. MOUNT

Surveyed JULY 11, 1986, by T. Warren