


44369
65539

SEC. 15
OCEANLAND

SEC. 10

SEC. 10

SEC. 3
OCEANLAND

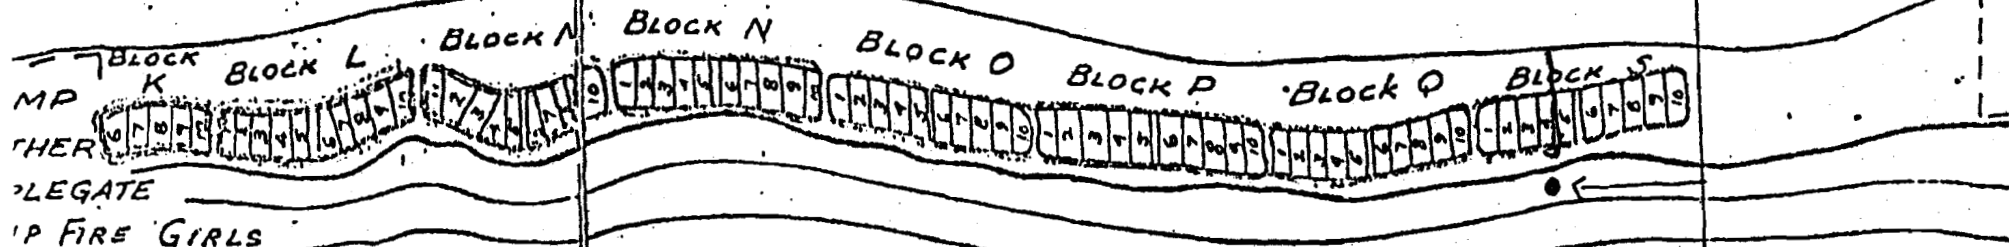

POINT OF DIVERSION 1377 E x 689 S of
SEC 10, T38 S R5 E, WM.

POINT OF USE - LOT 4, BLKS, LAKE OF THE WOODS
SUMMER HOME TRACT.

LAKE OF THE WOODS

RECEIVED

JUN 15 1979

WATER RESOURCES DEPT.
SALEM, OREGON

Application No. 58794
Permit No. 44369

LAKE OF THE WOOD
RESORT

WHITE PINE
PICNIC AREA

