


T.22S., R.46&47E., W.M.

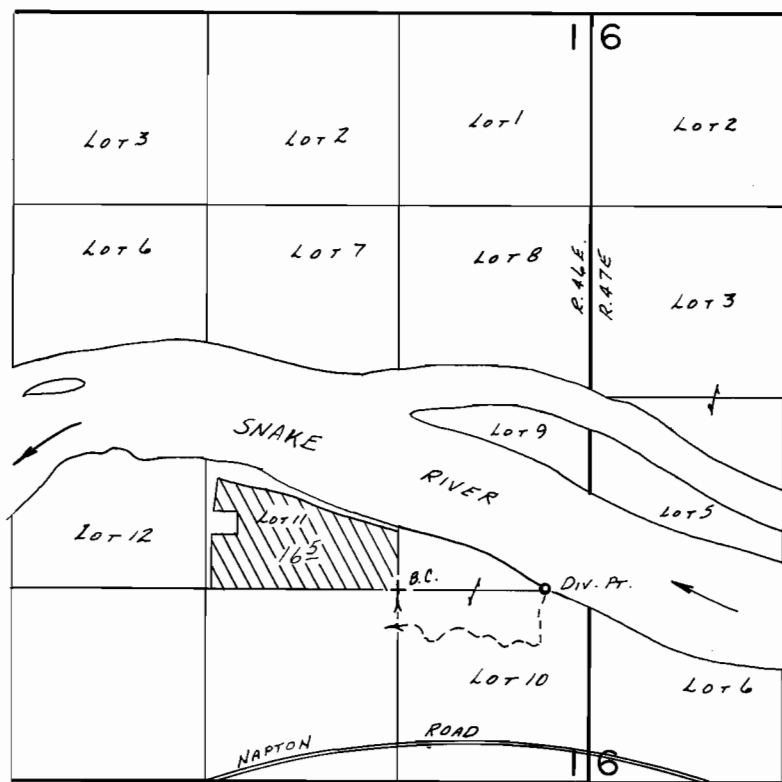

Div. Pt. Loc.: 20' N. & 10' 10" E. FROM SE COR. Lot 11.

SCALE: 1" = 1320'

FINAL PROOF SURVEY UNDER

Application No. 58815... Permit No. 44424...
IN NAME OF

B. B. BURROUGHS

Surveyed Mar. 26, 1986, by L. M. TOLL

3/5/87
BBC-3KK-68