


T.37S., R.5W., W.M.

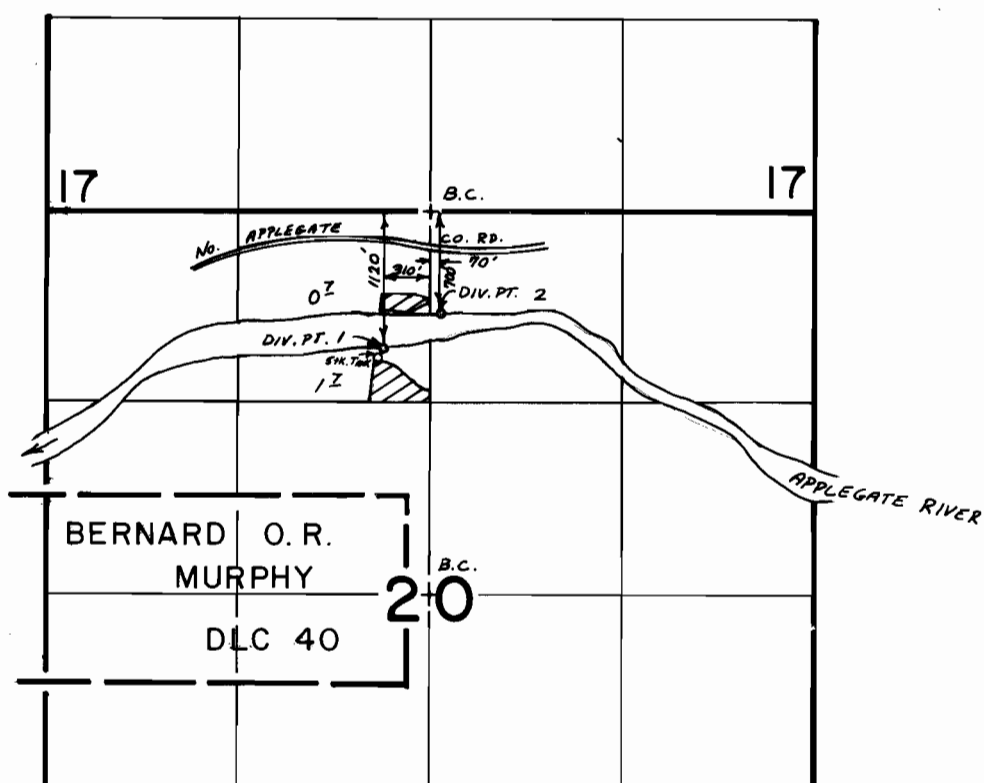

Scale: 4" = 1 Mile

FINAL PROOF SURVEY
UNDER

Application No. 58857 Permit No. 44761
IN NAME OF

WESLEY D. PARKER

Surveyed March 29 1982, by Bruce R. Sund