


T.4 S., R.3 E., W. M.

Sec. 8

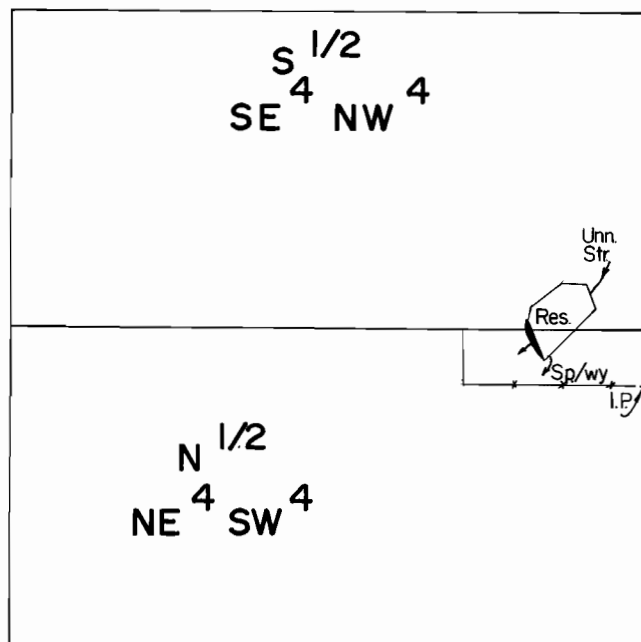

Dam P.O.D. Loc.: 30' S. & 230' W. from C. 1/4 Sec. 8.

Scale: 1" = 400'

FINAL PROOF SURVEY

UNDER

R - 59219

R-8133

Application No. 59220 Permit No. 44870

IN NAME OF

JACK QUIGLEY

Surveyed JULY 14, 1986, by T. Warren