


T. 25 S., R. 6 W., W.M. SECTION 13

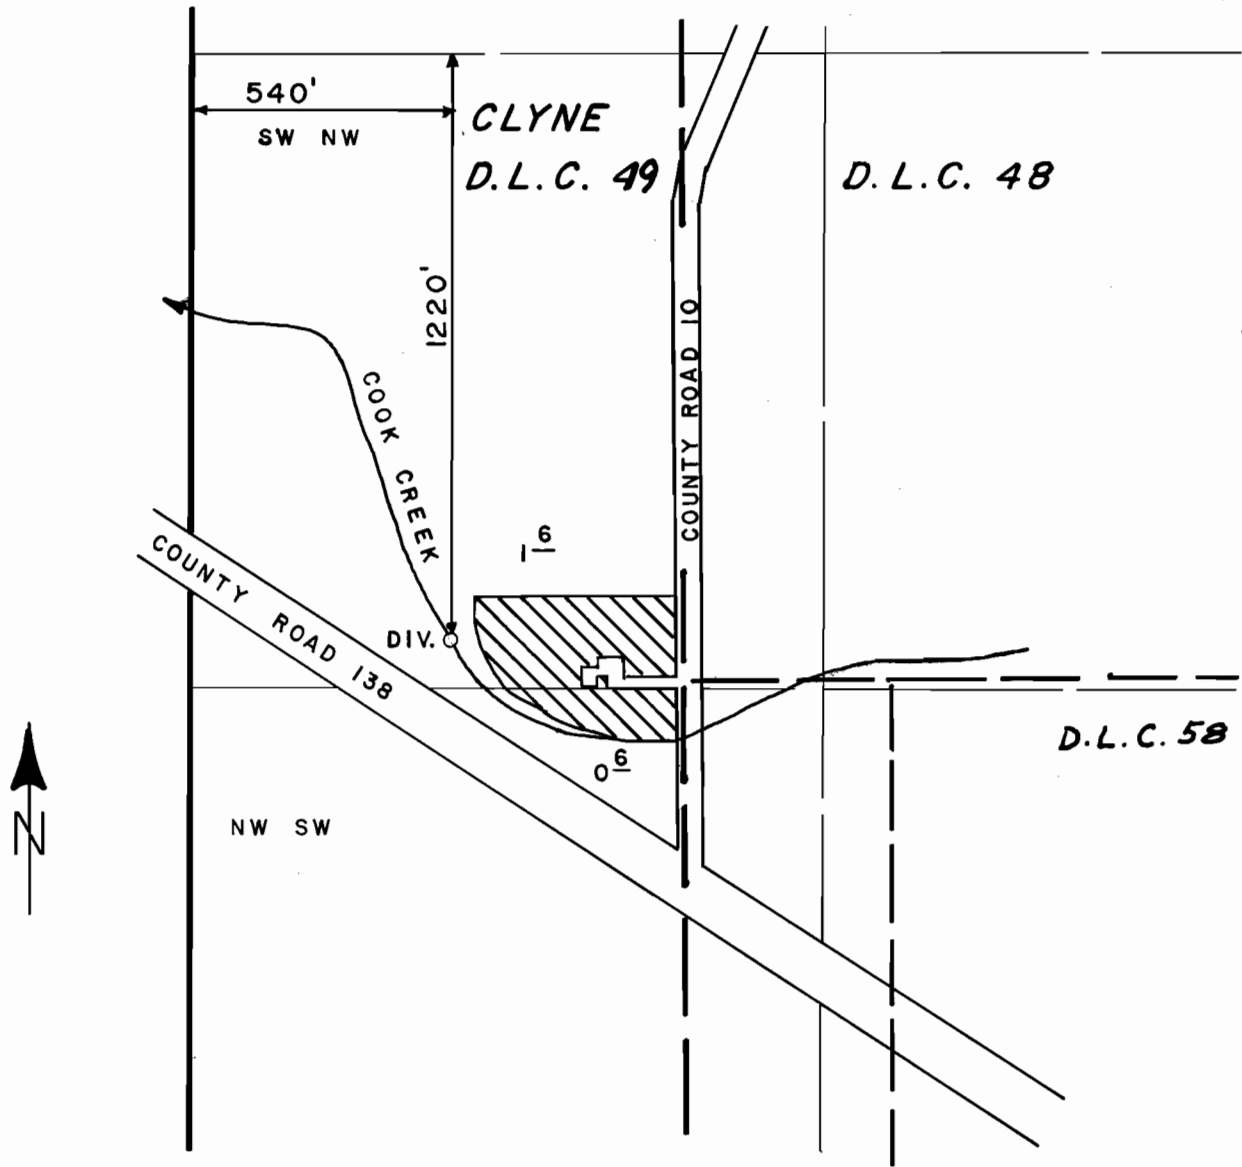

SCALE: 1" = 400'

FINAL PROOF SURVEY UNDER

Application No. 59314... Permit No. 44641.....
IN NAME OF

DAVID AND JAN MANSFIELD

Surveyed JULY 10, 1986, by J. M. SCHMORDE