


T. 27S., R. 3 W., W. M.

SECTIONS 14 & 23

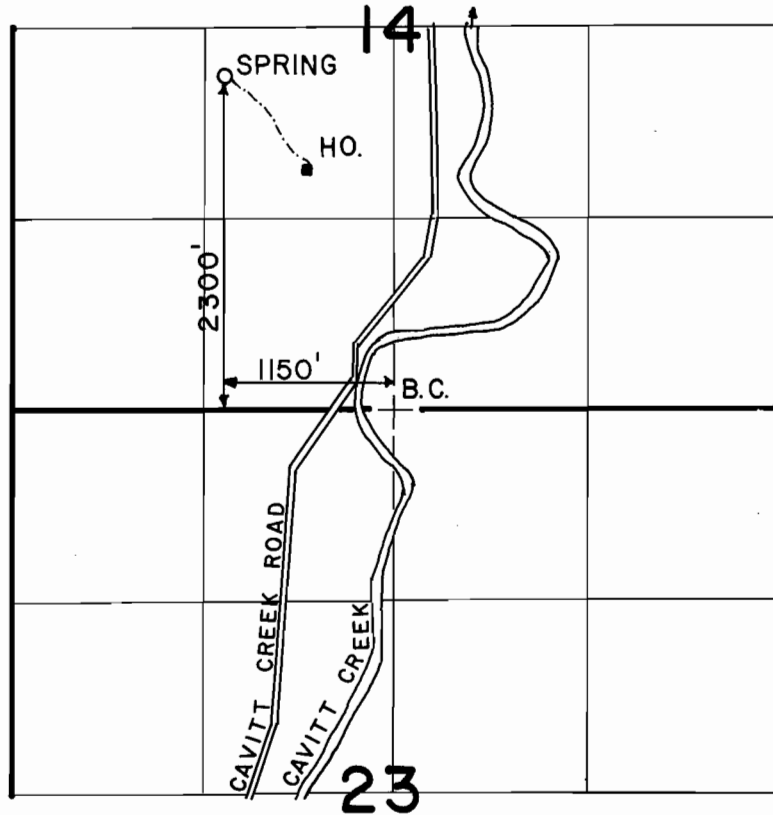

SCALE: 4" = 1 MILE

FINAL PROOF SURVEY UNDER

Application No. 59326... Permit No. 44642.....
IN NAME OF

.....JOSEPH S. DANCHOK.....

Surveyed APRIL 26 1986, by J.M. SCHMORDE