


# T. 37 S., R. 1 W., W. M.

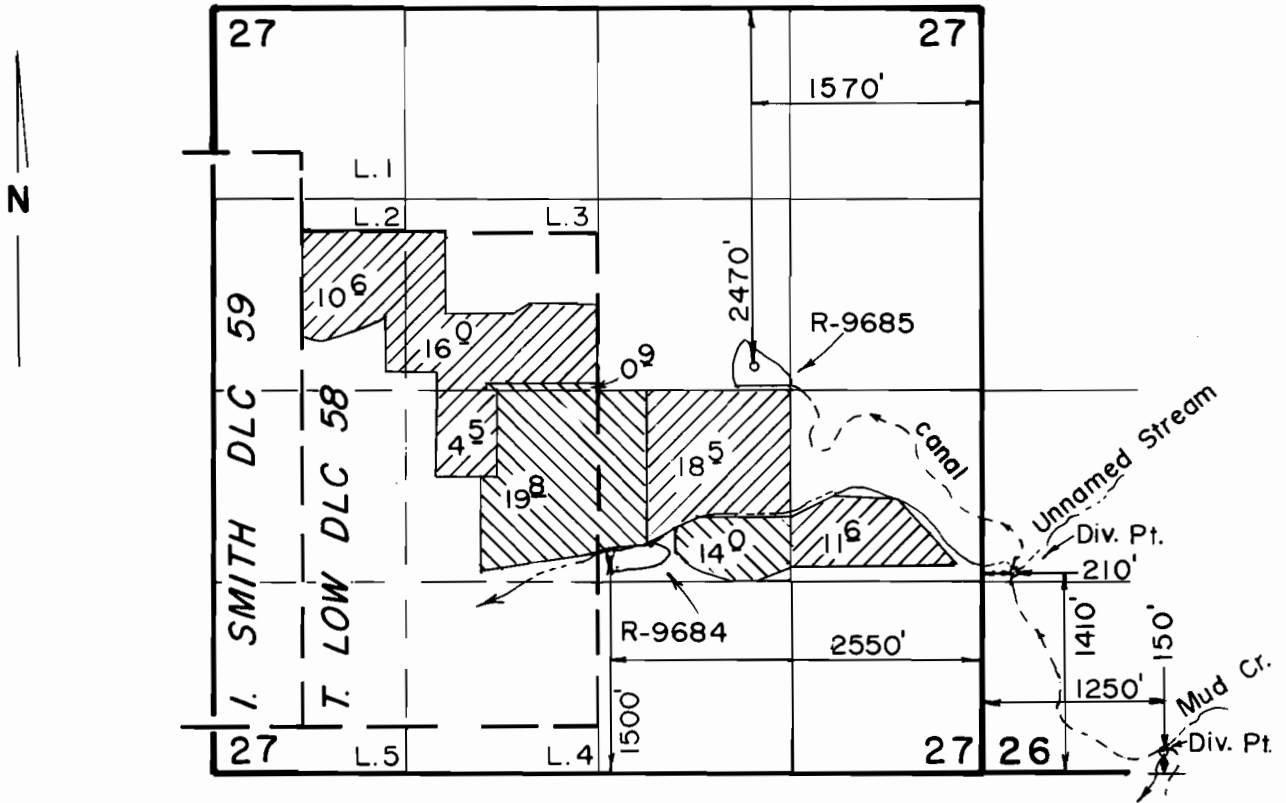

Scale: 1" = 1320'



Permit 48399



Permit 48400

## FINAL PROOF SURVEY

UNDER

|         |        |
|---------|--------|
| R-58686 | R-9684 |
| 58687   | 48399  |
| R-60207 | R-9685 |

Application No. 60208... Permit No. 48400.....

IN NAME OF

**CRYSTAL SPRINGS PACKING CO.**

Surveyed NOV. 19. 19.87, by B. S. JAMES.....