


T. 34 S., R. 3 W., W. M.

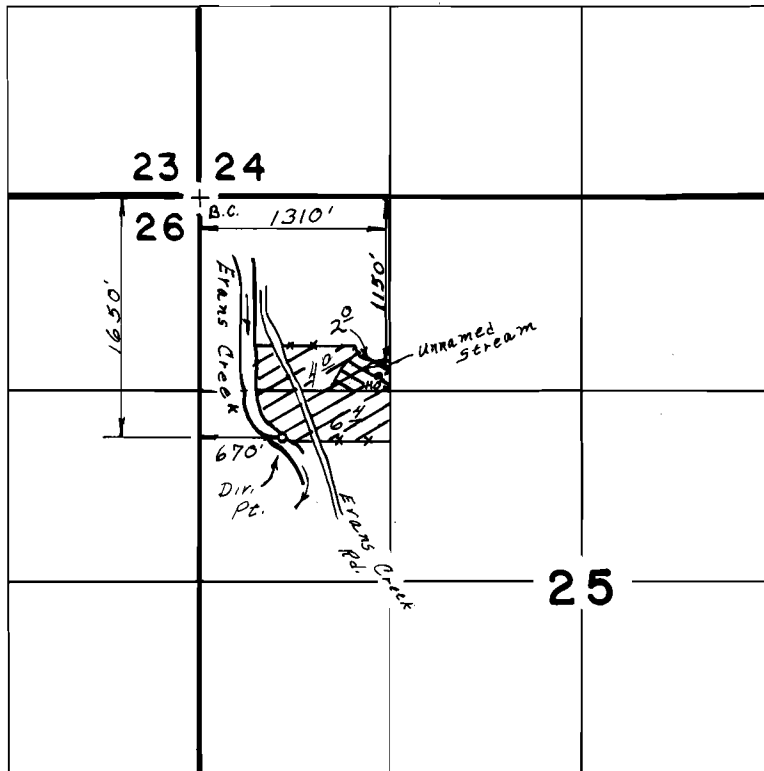

Scale: 1" = 1320'

FINAL PROOF SURVEY


UNDER

58579

44124

61703

45880

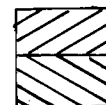

Application No. Permit No.

IN NAME OF

ROBERT C. & PENNY J. GILKEY

Surveyed JUN. 9. 19.8.7, by B. S. JAMES...