


T.36.S., R.3 W., W.M.

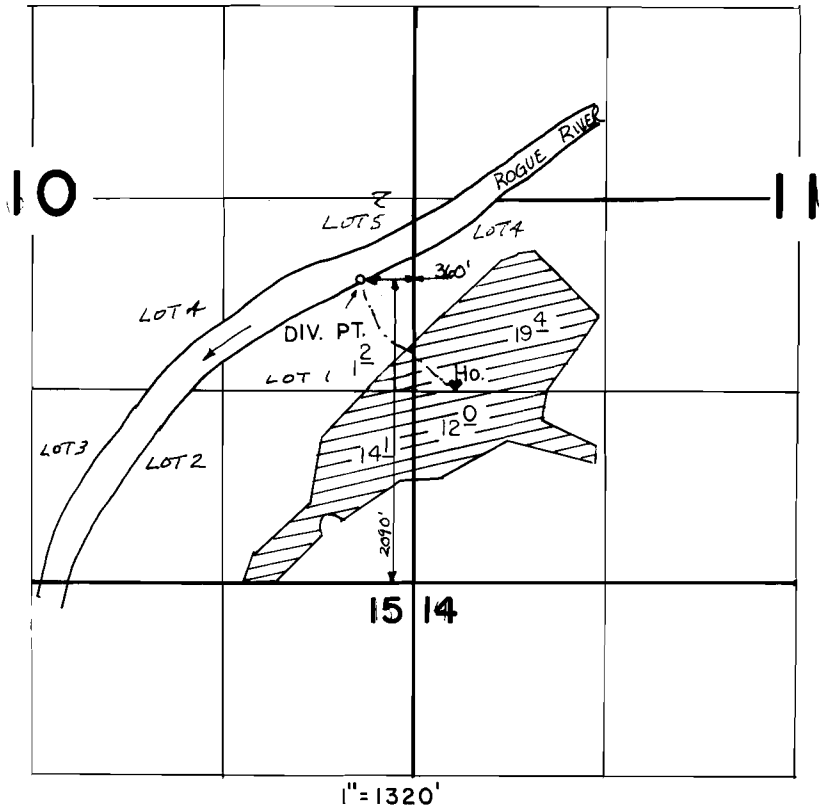

FINAL PROOF SURVEY UNDER

Application No. 55853 61904 Permit No. 41900 45888

IN NAME OF

RICHARD OR ROBERT HALDEMAN

Surveyed JUNE 8, 1983, by B. S. JAMES