
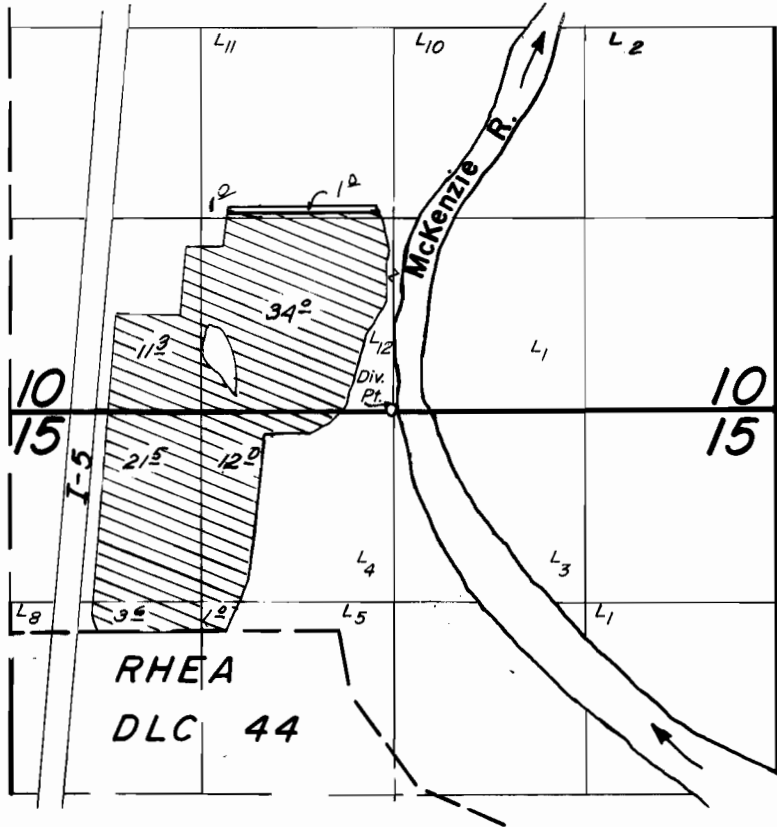


# T.17S., R.3W., W.M.

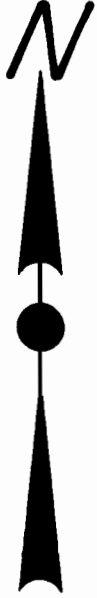

Div. Pt. Loc. : 2640' W. from SE Cor. Sec. 10.

Scale: 1" = 1320'

## FINAL PROOF SURVEY UNDER

Application No. 63542.. Permit No. 47969.....

IN NAME OF

WALTER JOHNSON

Surveyed May 23 1985, by T. Warren.....