




T.24S., R.7 W., W.M. SECTIONS 31 & 32

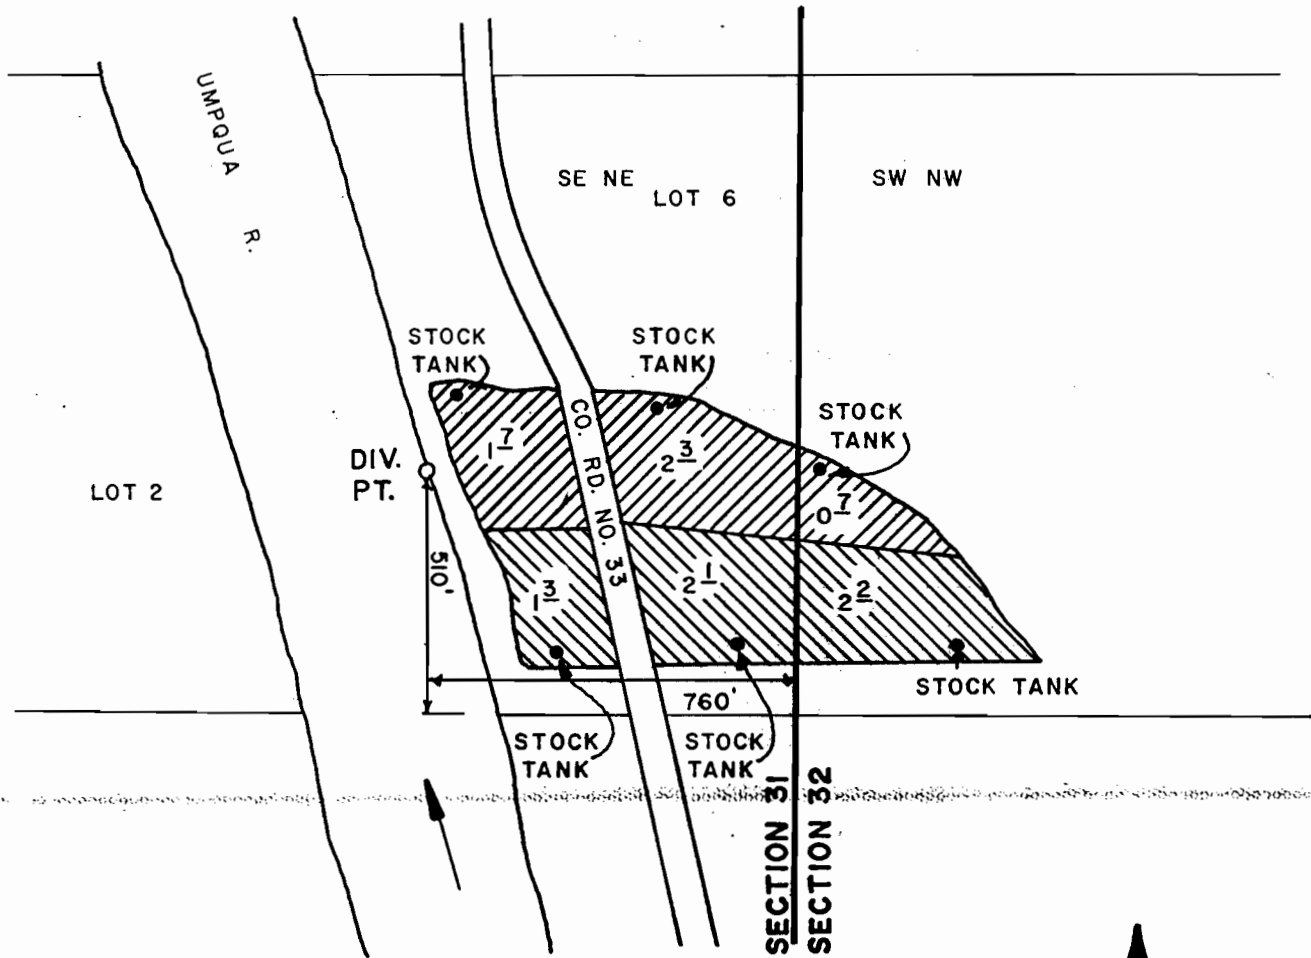

SCALE 1" = 400'

-  IRRIGATION UNDER A. NO. 57682
-  IRRIGATION UNDER A. NO. 64545

FINAL PROOF SURVEY UNDER

57682 43479
 Application No. 64545 Permit No. 47289
 IN NAME OF

LARRY R. FURRER

Surveyed AUG. 13. 1986, by J. M. SCHMORDE