90684

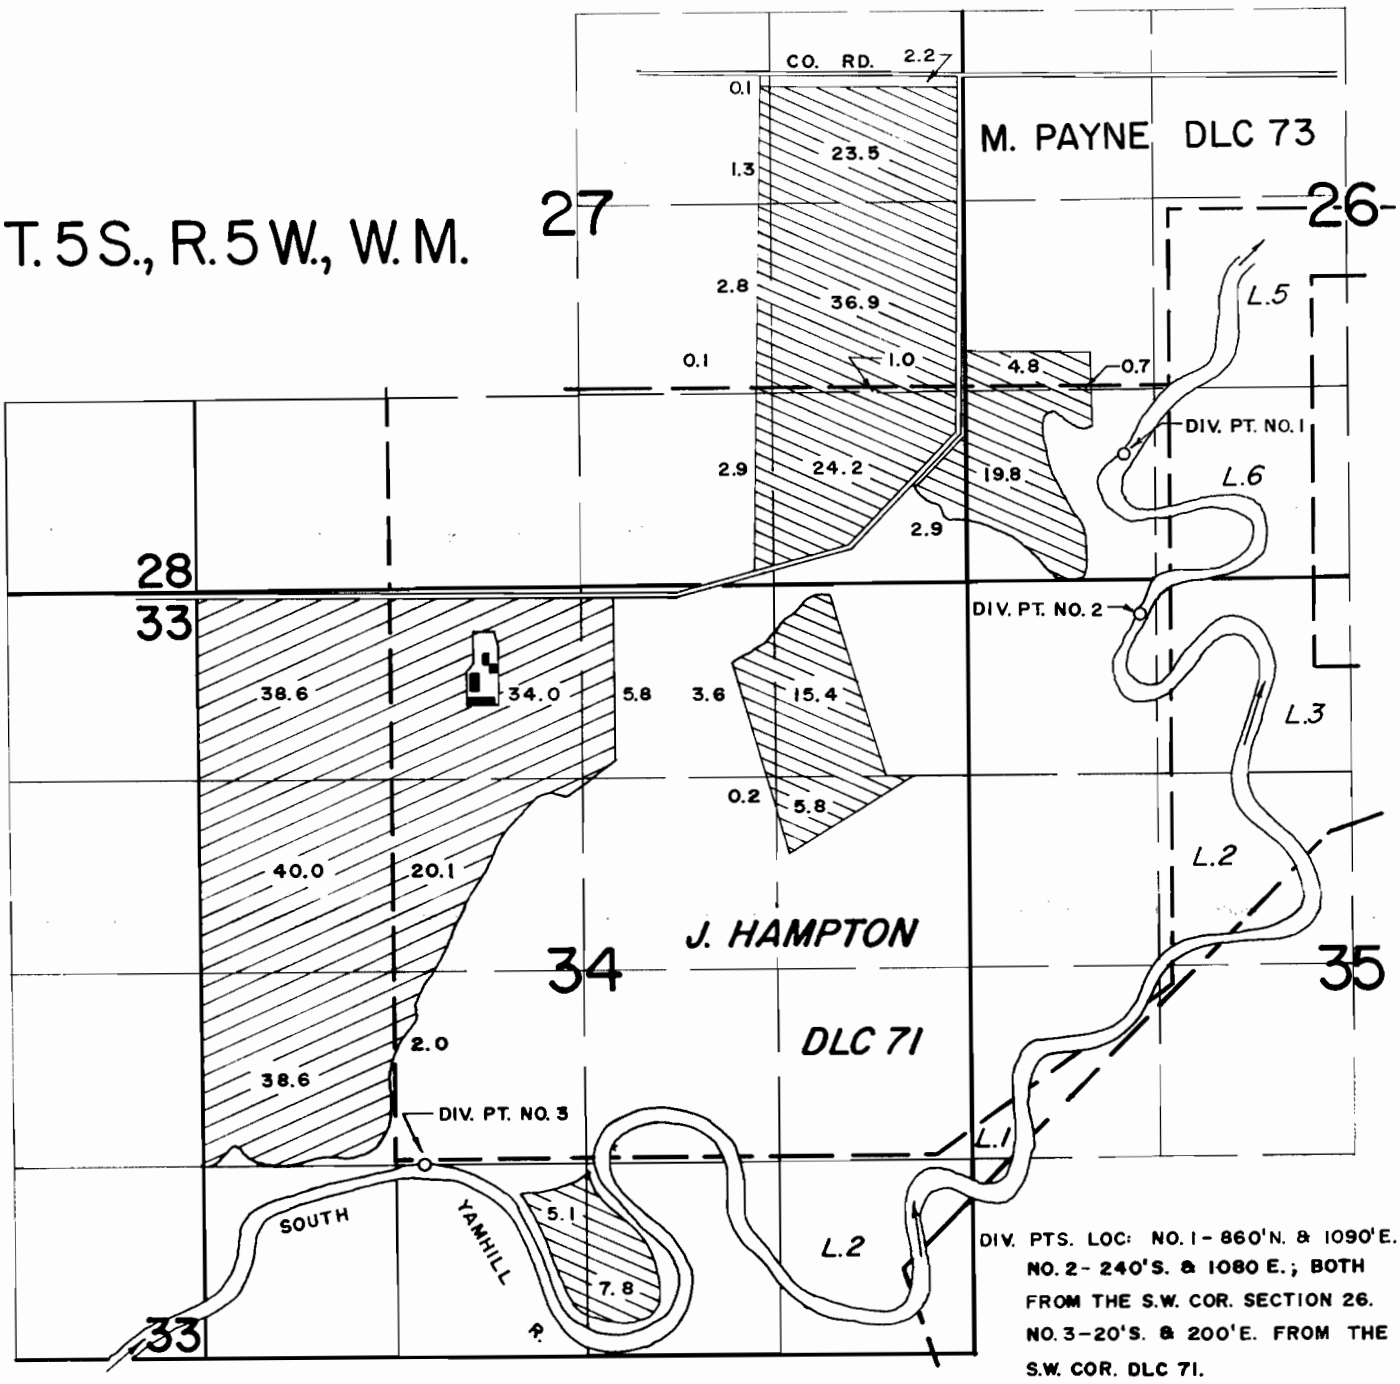

PERMIT NO. 43966

PERMIT NO. 47681

FINAL PROOF SURVEY
UNDER

58374 43966

APPLICATION NO. 65280 PERMIT NO. 47681

N

SCALE: 4" = 1 MILE

CRIMSON WEST FARMS, INC.

SURVEYED OCTOBER 2, 1984 BY P. Pagter

41071-178-75C PRP 3/4/85