


T. 29S., R. 4W., W. M.
SECTION 5

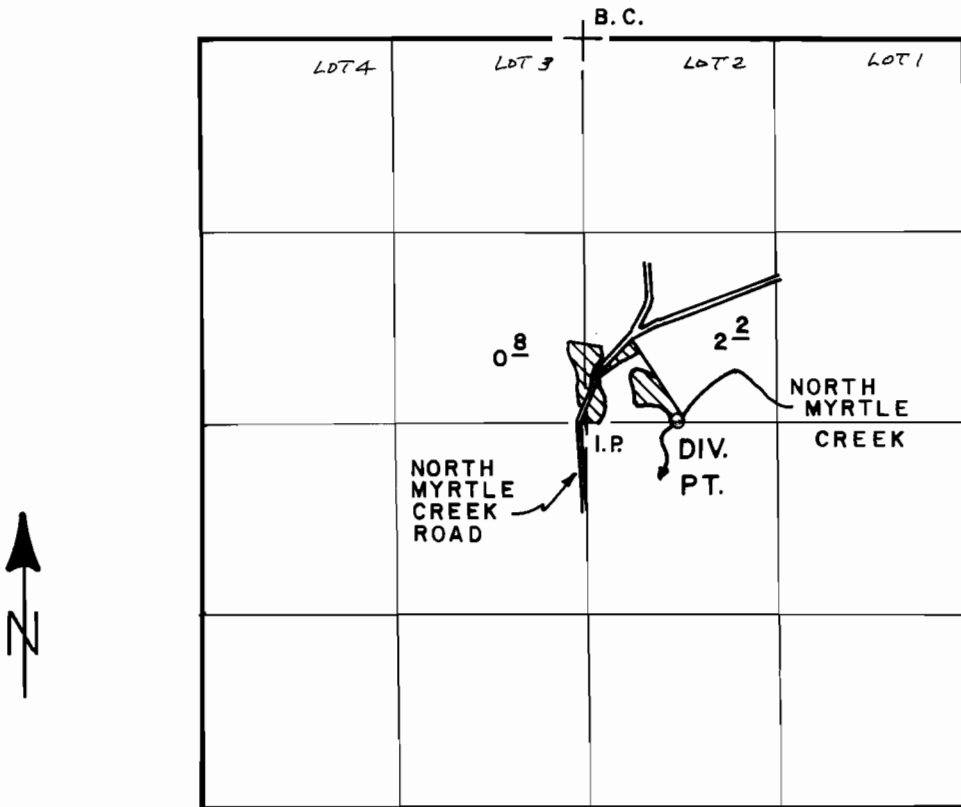

DIV. PT. LOCATED 20' N. & 610' E. FROM CENTER 1/4 SEC. 5.

SCALE: 4" = 1 MILE

FINAL PROOF SURVEY
UNDER

TRANSFER NUMBER T-5319

Application No. 65309... Permit No. 47923...
IN NAME OF

CLINTON DENNIS BROWN

Surveyed AUG. 26 1987, by J. M. SCHMORDE