


T. 1N., R. 4W., W.M.

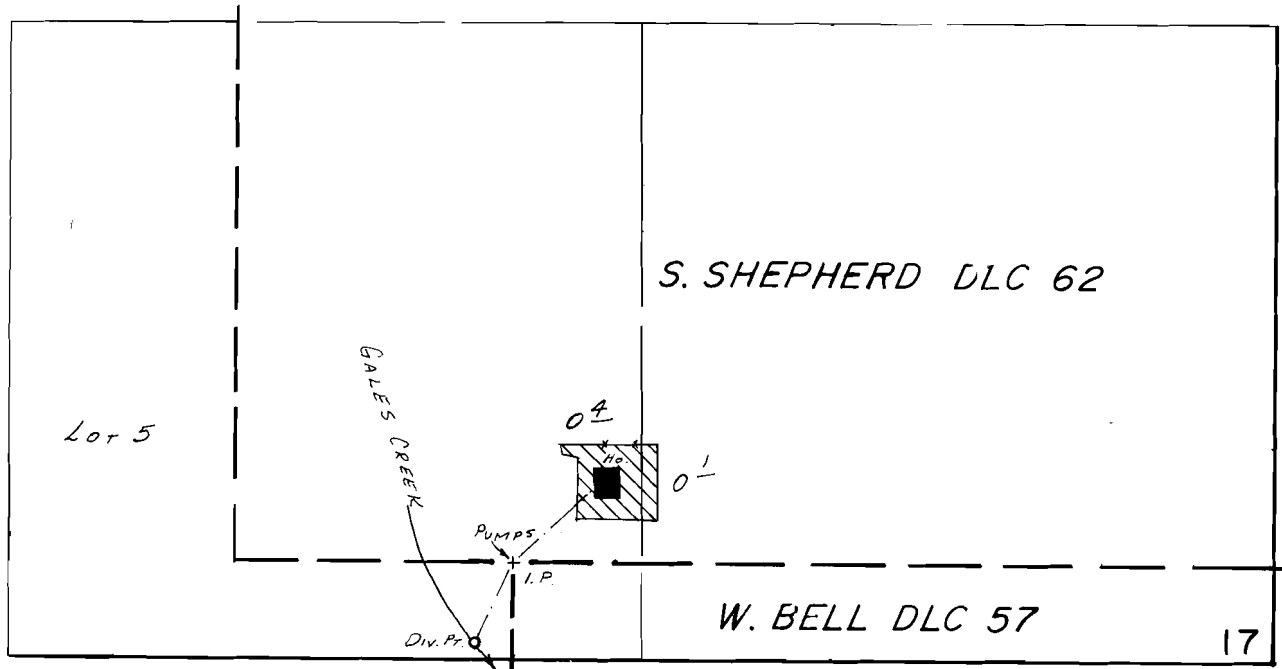

Div. Pt. Loc.: 170'S. & 80'W. FROM NW COR. W. BELL DLC 57.

SCALE: 1" = 400'

FINAL PROOF SURVEY UNDER

Application No. 65575.. Permit No. 47996.....
IN NAME OF

RUSSELL O'CONNOR.....

Surveyed Sept. 4.... 19.86, by B.W. BISHOP.....