


90684
T. 29S., R. 4W., W.M.
SECTIONS 7 & 8

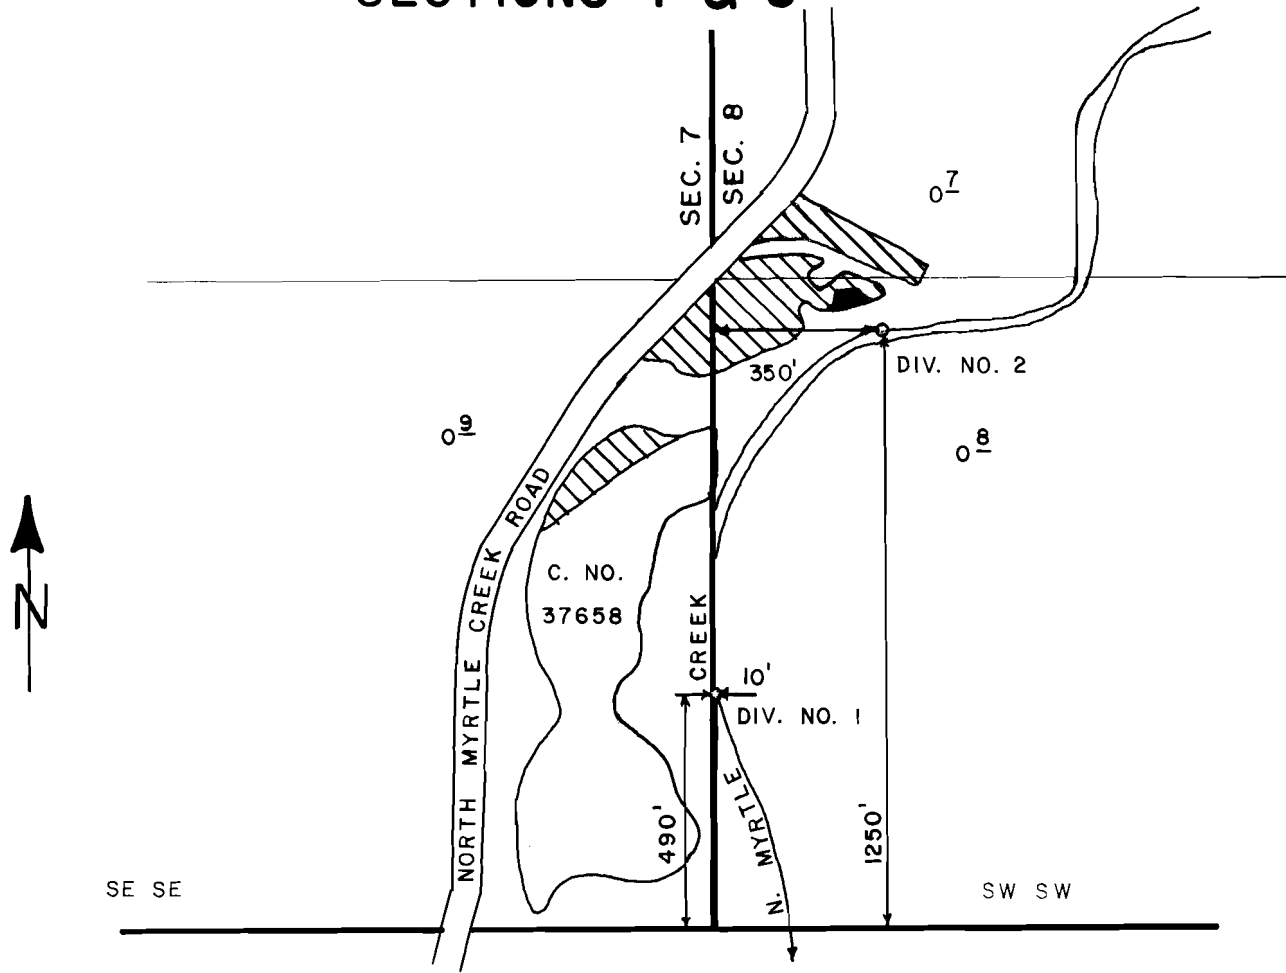

SCALE: 1" = 400'

FINAL PROOF SURVEY
UNDER

Application No. 65590 Permit No. 48001
IN NAME OF

HAROLD F. NEALE

Surveyed MAY 13 1986, by J. M. SCHMORDE