


Application No. R-65612 & 65613
Permit No. R 8992 48006

RECEIVED
AUG 25 1993
WATER RESOURCES DIVISION
SALMON, OREGON

T.28S., R.6W., W.M.

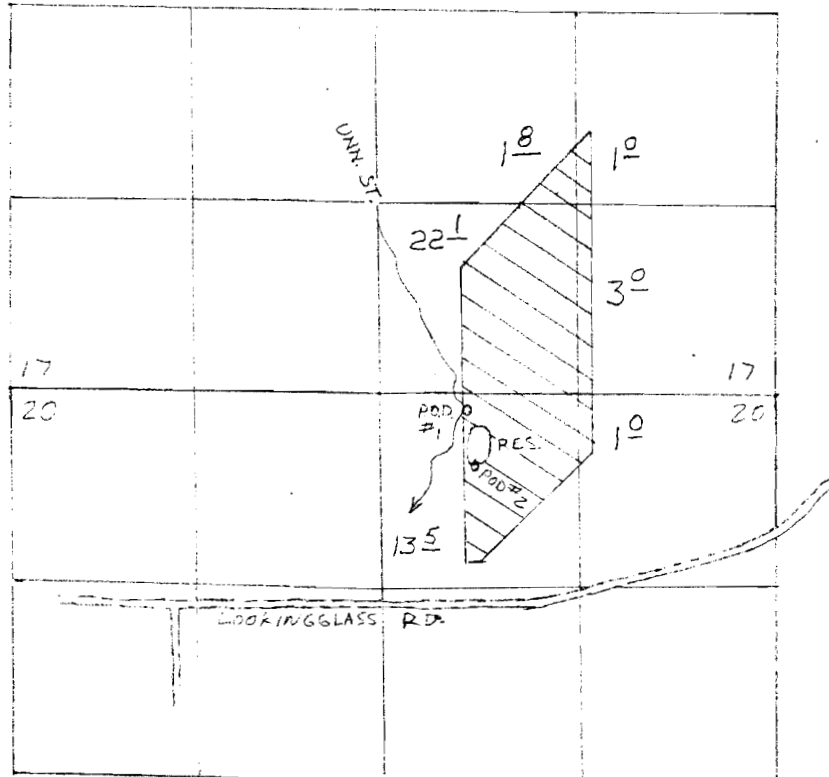

R.O.D LOCATED: #1 - 100'S & 600'E } FROM
#2 - 500'S & 650'E } N¹/₄ COR
SEC. 20