


T. 28S., R. 6W., W.M. SECTIONS 32 & 33

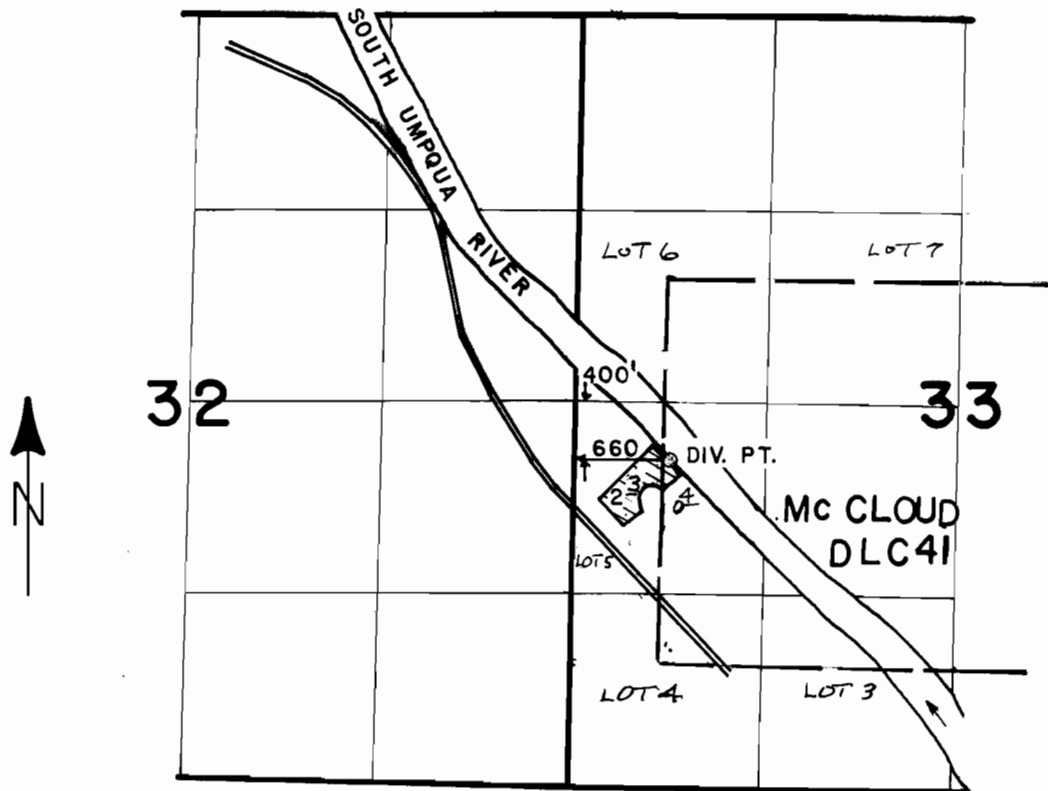

SCALE: 4" = 1 MILE

FINAL PROOF SURVEY UNDER

Application No. 6.6728. Permit No. 48125.....
IN NAME OF

JAMES G. BARTZ

Surveyed MAY 14 1987, by J. M. SCHMORDE