


T. 36 S., R. 5 W., W. M.

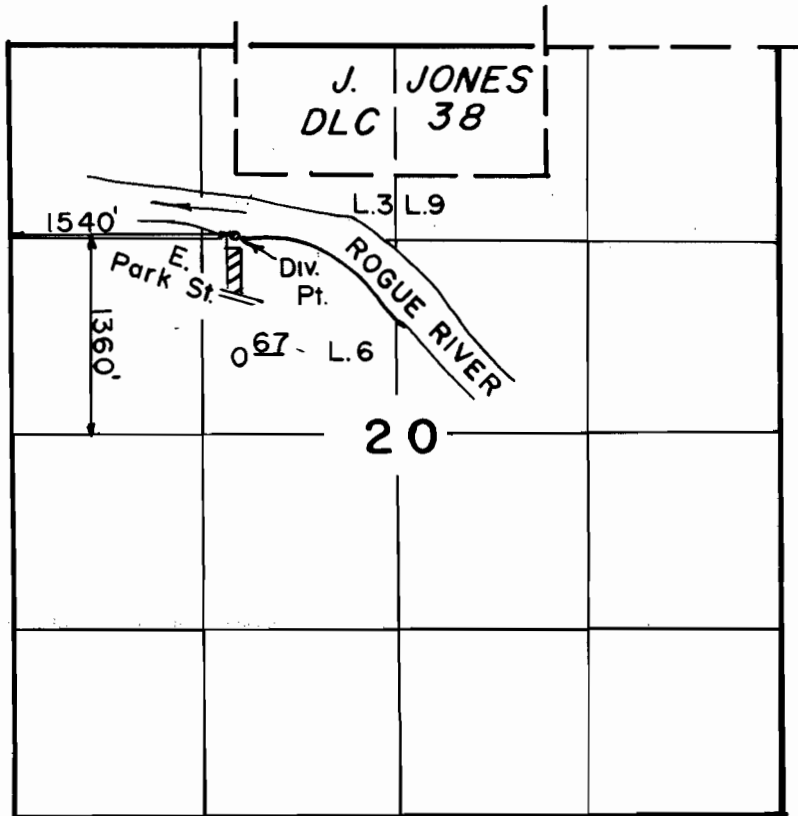

Scale: 1" = 1320'

FINAL PROOF SURVEY
UNDER

Application No. 67.322 Permit No. 48.184...
IN NAME OF

.....ROBERT.....M.....THOMPSON.....

Surveyed AUG...6.. 1987, by B...S.....JAMES.....