


T. 32S., R. 5 W., W.M. SECTIONS II & 14

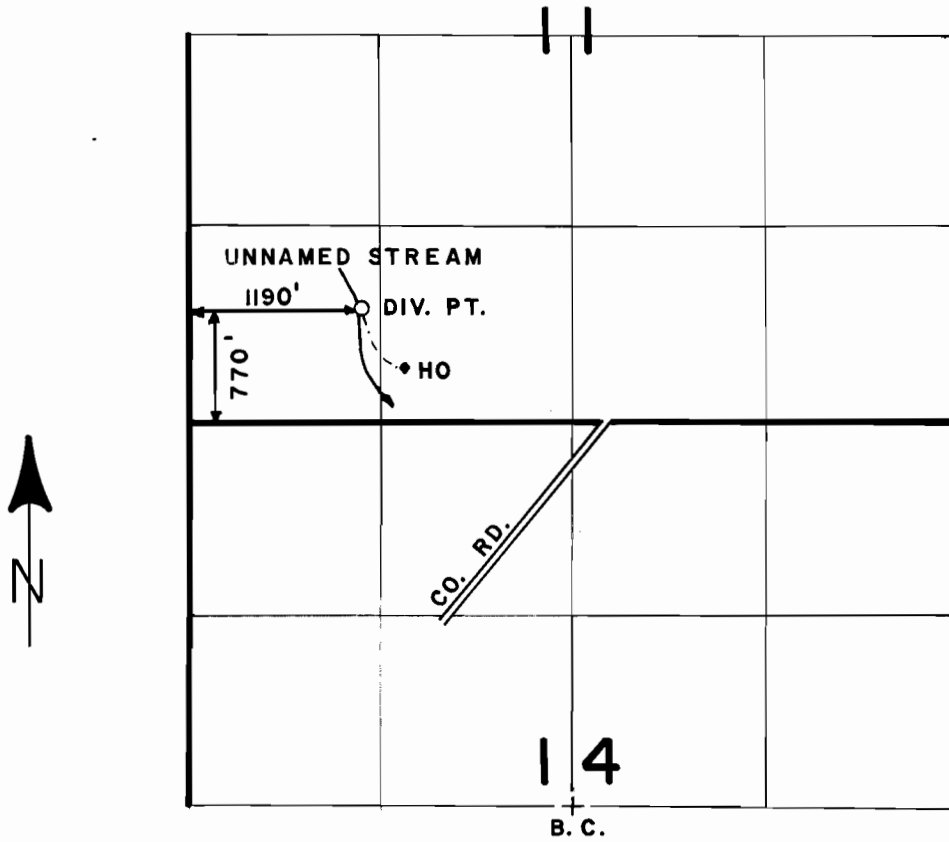

SCALE: 4" = 1 MILE

FINAL PROOF SURVEY UNDER

Application No. 67358 Permit No. 48162
IN NAME OF

ROBERT & NORMA WINKELMAN

Surveyed JUNE 10, 1987, by J. M. SCHMORDE