


# T. 28S., R. 6W., W.M.

## SECTIONS 15 & 16

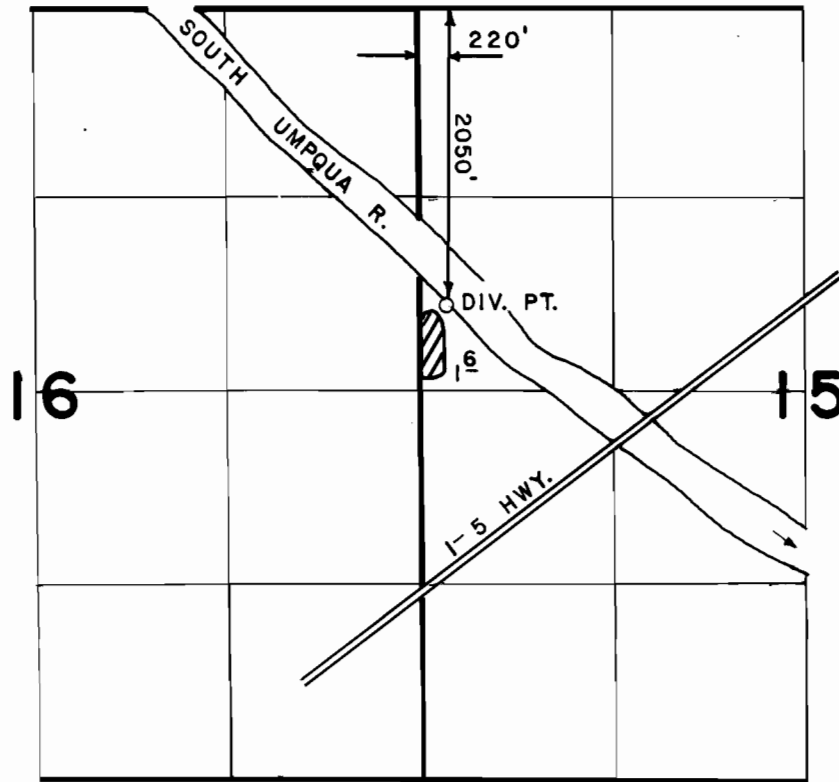

SCALE: 4" = 1 MILE

### FINAL PROOF SURVEY UNDER

Application No. 67416... Permit No. 48164.....  
IN NAME OF

**GLEN G. GALLA & EULETA J. GALLA**

Surveyed MAY 5, 1987, by J. M. SCHMORDE

29773