


T. 26 S., R. 5 W., W.M.

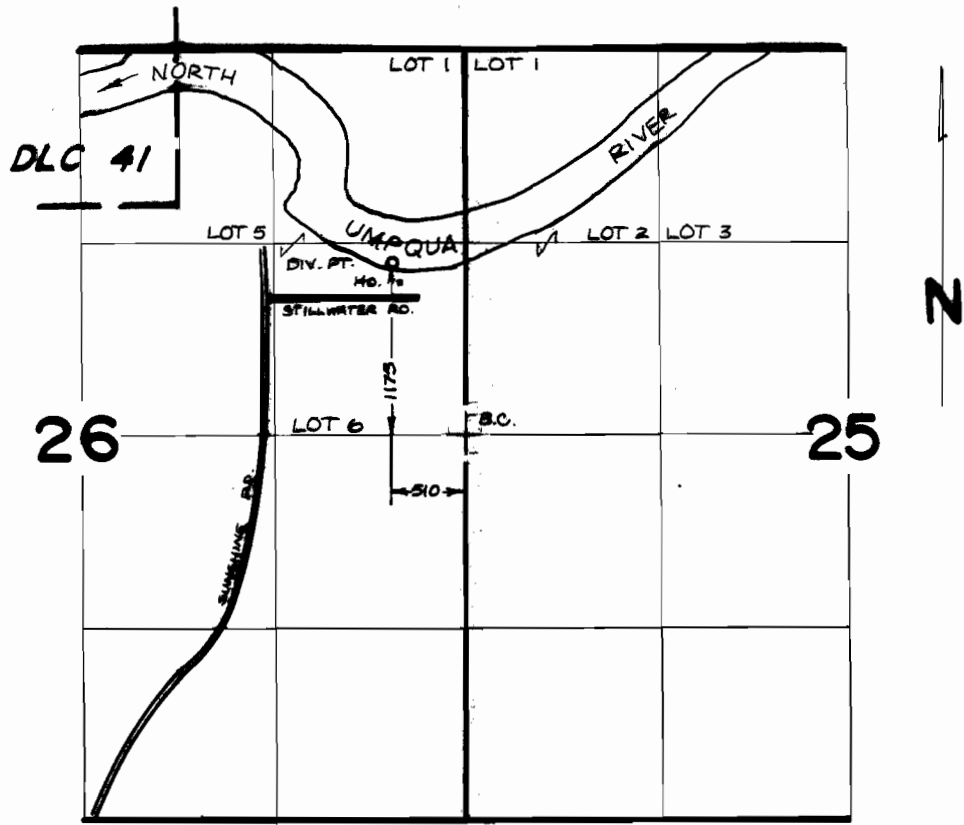

SCALE: 4" = 1 MILE

FINAL PROOF SURVEY UNDER

Application No. ..67725. Permit No.48212....
IN NAME OF

.....RONALD S. LANGE.....

Surveyed ..OCT..9,.. 19.86., by ..J.M..SCHMORDE..