


T. 36 S., R. 5 W., W. M.

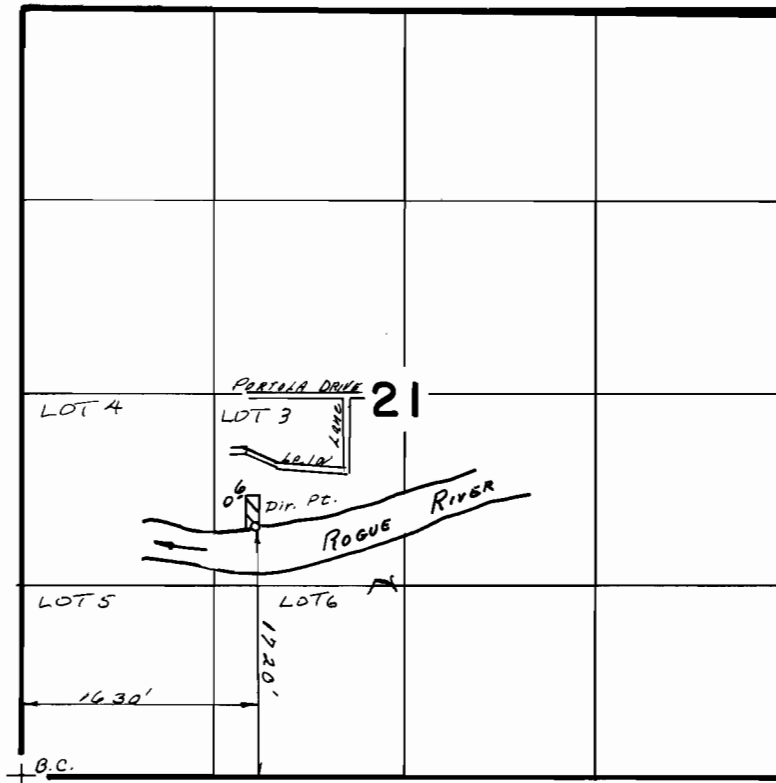

Scale: 1" = 1320'

**FINAL PROOF SURVEY**  
UNDER

Application No. 67987. Permit No. 48307.  
IN NAME OF

RICHARD TRESEMER

Surveyed AUG. 3. 1987, by B. S. JAMES.