


# T. 25 S., R 4 W., W. M.

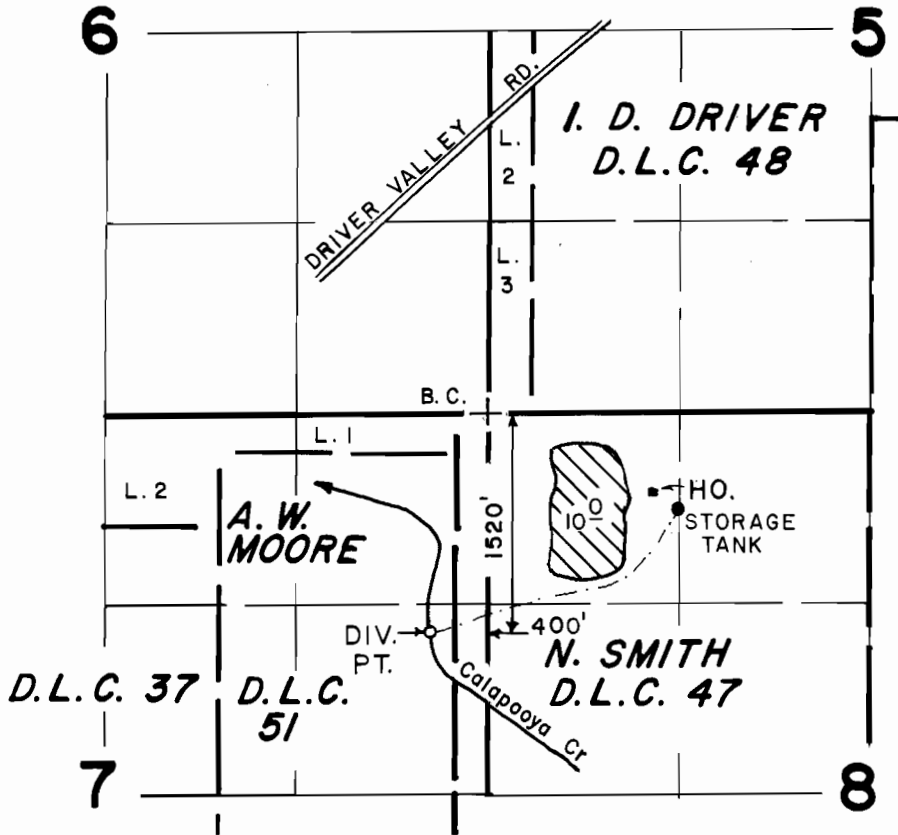

SCALE: 4" = 1 MILE



## FINAL PROOF SURVEY UNDER

Application No. 68031 Permit No. 48415.....  
IN NAME OF

PAUL H DAMOND

Surveyed JUNE 9 1987, by J. M. SCHMORDE