


T.27S., R.3W., W.M.

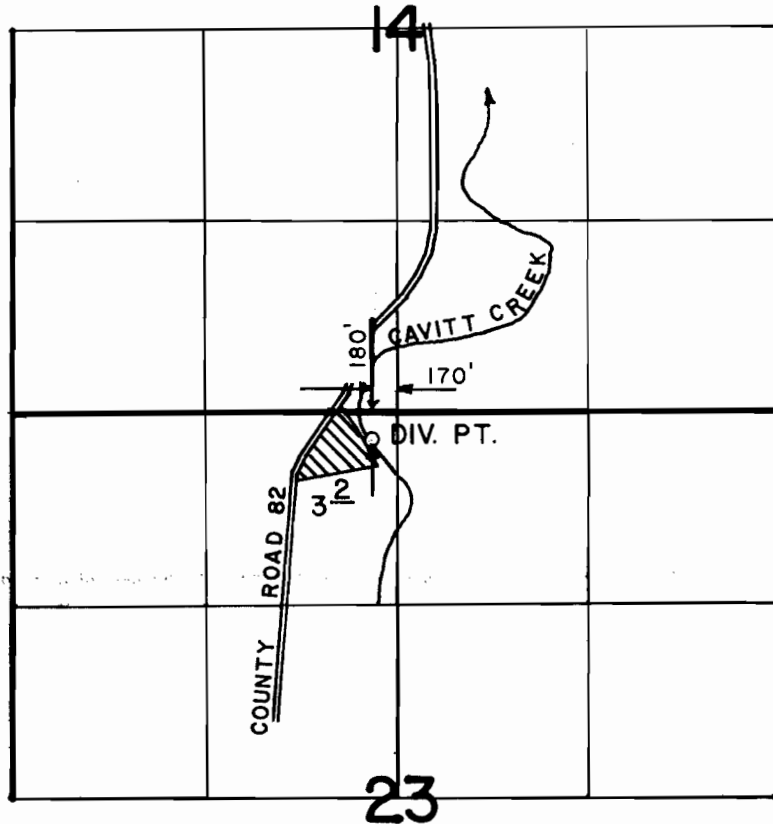

SCALE: 4" = 1 MILE

**FINAL PROOF SURVEY**  
UNDER

Application No. 68094. Permit No. 48548.....  
IN NAME OF

JOHN B. WHITE SR., YVONNE WHITE

Surveyed APRIL 7, 1988, by J. M. SCHMORDE