


T.35 S., R.7 W., W.M.

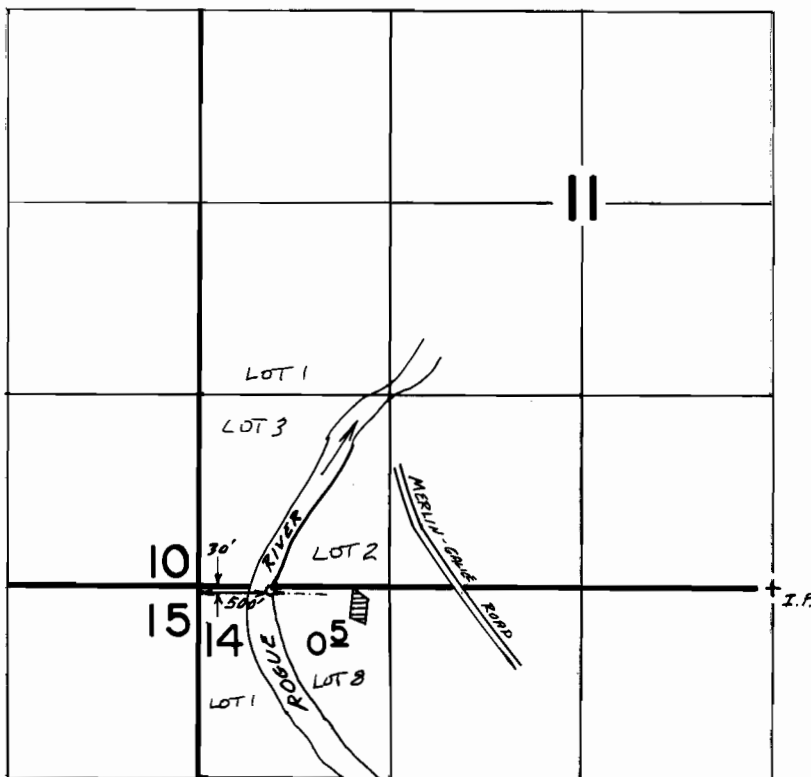

Scale 1" = 1320'

FINAL PROOF SURVEY UNDER

Application No. 68164... Permit No. 48836.....

IN NAME OF

W. WARD GREEN.....

Surveyed Oct. 27.. 1987.. by B.S. JAMES.....