

R-6824 & 6825

Application No. R10053
Permit No. 49000

NOBLE MOUNTAIN TREE FARM
EOLA HILLS CHRISTMAS TREE PLANTATION
SECTIONS 11, 12, 13, 14, T6S, R4W, WM.


rev June 1978 Genetechs R.Courter

SCALE: APPROX. 1 INCH TO 400 FEET

TO LINCOLN-SALEM

LEGEND:

- ROADS (GRAVEL) ———
- ROADS (DIRT) - - - -
- STRUCTURES □
- PLANTATION
- FENCE — x — x — x
- FIELD
- WOODLAND
- WATERCOURSE ———→
- SPRING *
- TRAIL OR BOUNDARY - - - -
- HELIPORT-YARD

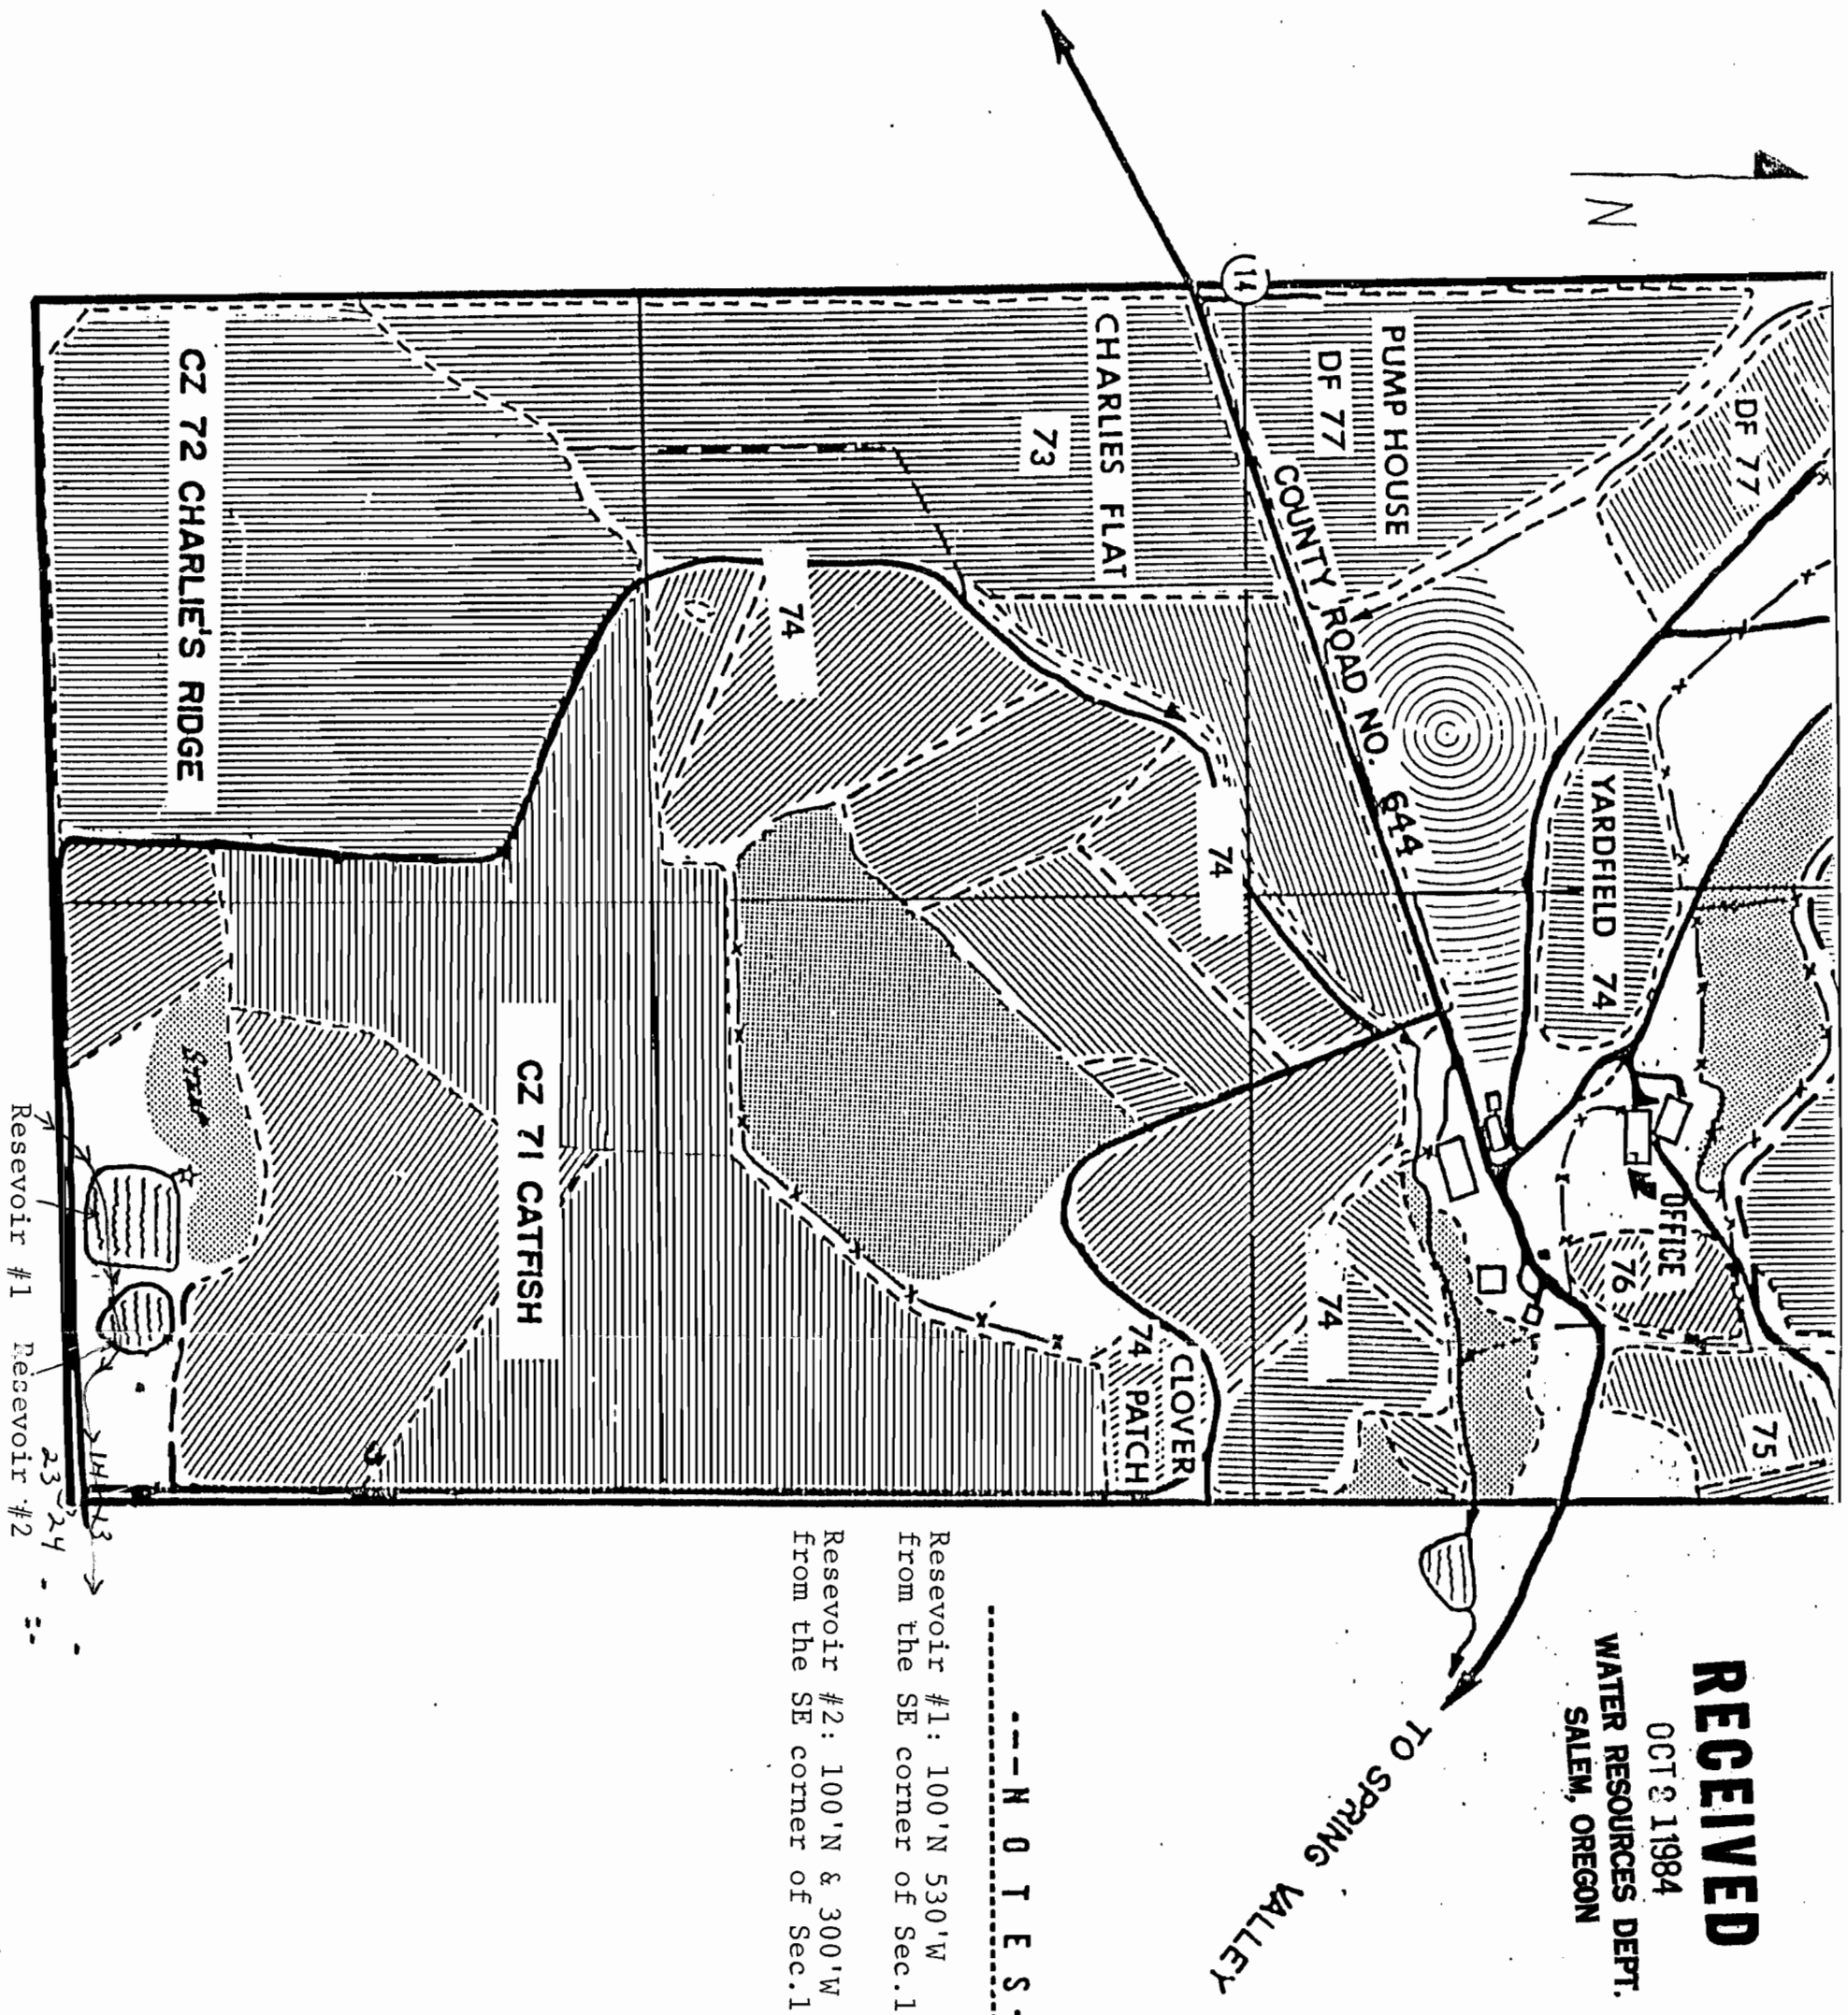

RECEIVED
OCT 2 11984
WATER RESOURCES DEPT.
SALEM, OREGON

---NOTES---

Reservoir #1: 100'N 530'W
from the SE corner of Sec.14
Reservoir #2: 100'N & 300'W
from the SE corner of Sec.14

Reservoir #1 Reservoir #2
23-24