


T.6S., R.4W., W.M.

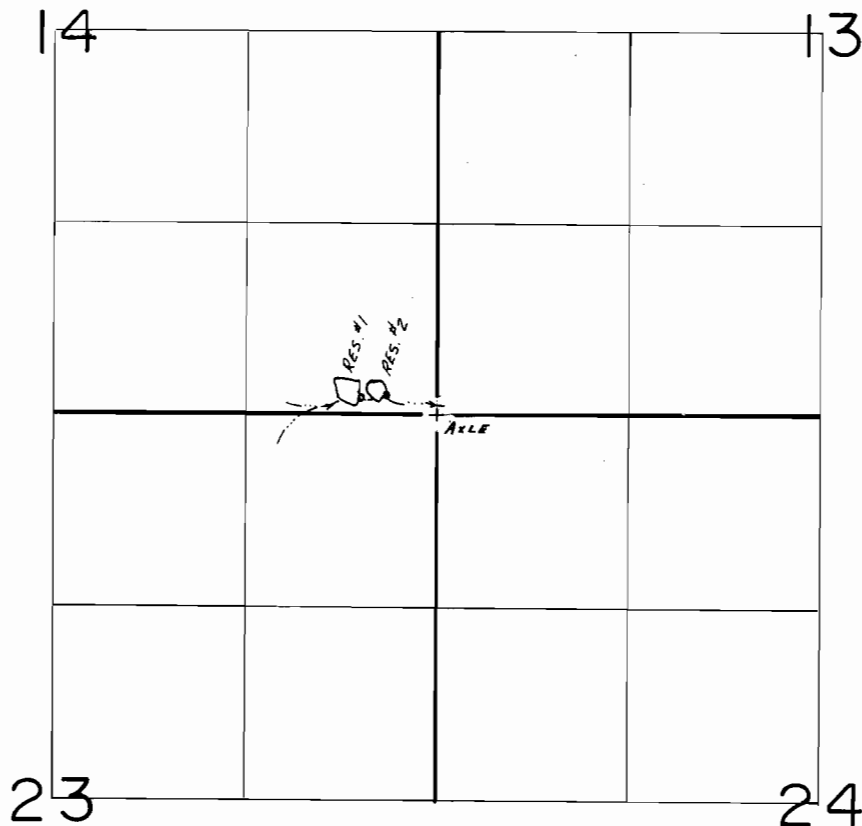

DIV. PTS LOC.: #1-130' N. & 540' W., #2-150' N. & 350' W., BOTH
FROM SE COR. SEC. 14

SCALE: 1" = 1320'

FINAL PROOF SURVEY UNDER

R-68214 R-10053
Application No. 68215... Permit No. 49000.....
IN NAME OF

.....NOBLE MOUNTAIN TREE FARM.....

Surveyed Oct...1..... 19.86, by B.W. BISHOP.....

1-16-87

AMB

41059-178-219D