
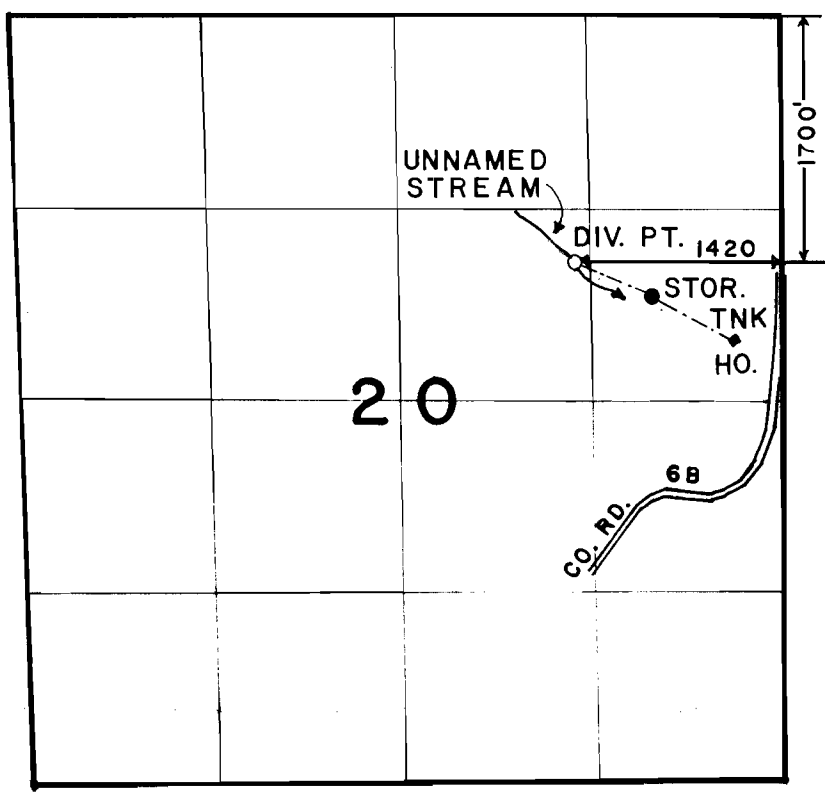


T. 25 S., R. 7 W., W.M.

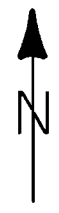

SCALE: 4" = 1 MILE

FINAL PROOF SURVEY UNDER

Application No. 68228 Permit No. 49189.....
IN NAME OF

H. B. GERMOND AND MELBA L. GERMOND

Surveyed OCT. 13, 1987, by J. M. SCHMORDE