


T. 29 S., R 6 W., W.M.

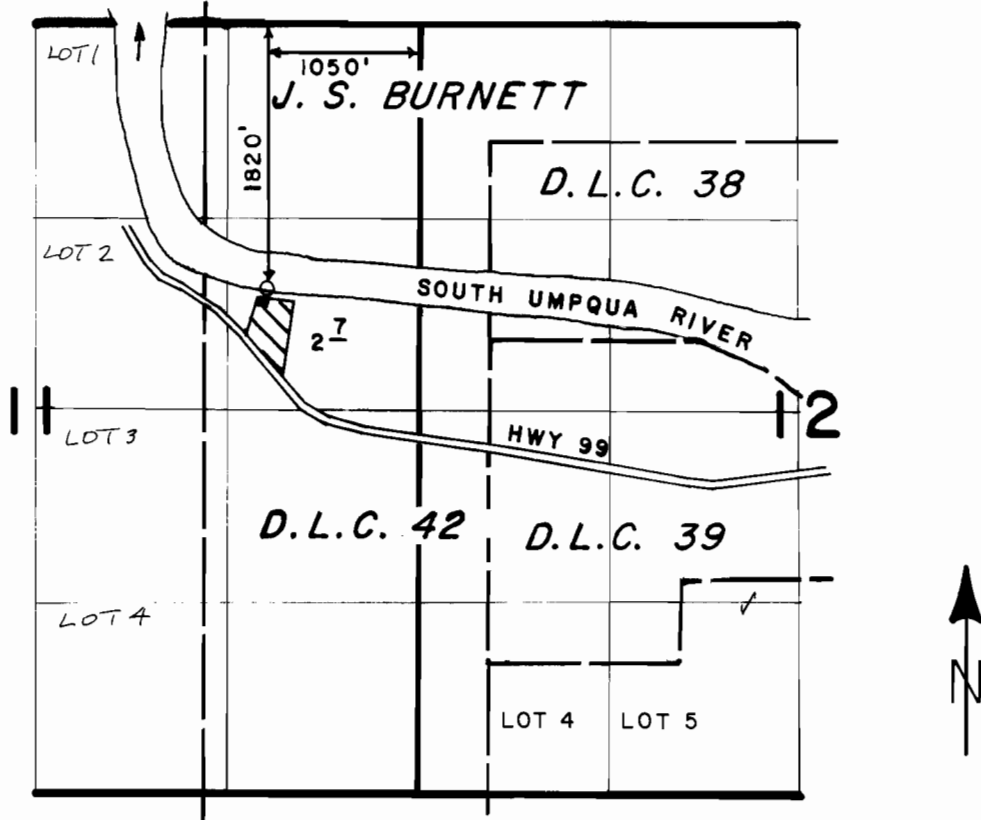

SCALE: 4" = MILE

FINAL PROOF SURVEY UNDER

Application No. 68308... Permit No. 49275.....
IN NAME OF

DONALD M. AUER

Surveyed JUNE 29, 1987, by J. M. SCHMORDE