


T. 18 S., R. 22 E., W. M.

PERMIT-R10893

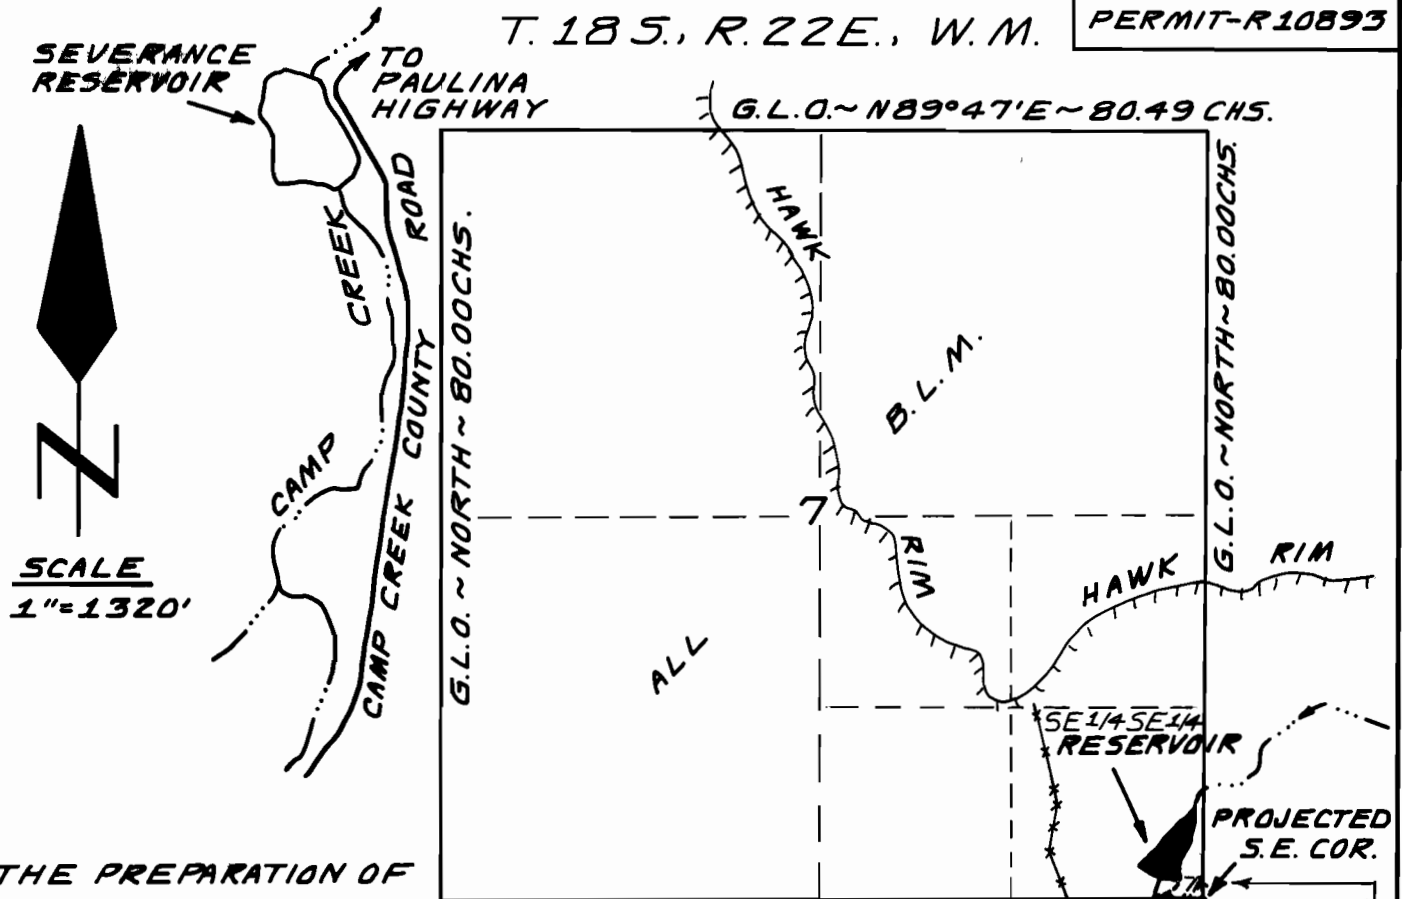

THE PREPARATION OF THIS MAP IS FOR THE PURPOSE OF IDENTIFYING THE LOCATION OF THE WATER RIGHT ONLY AND HAS NO INTENT TO PROVIDE DIMENSIONS OR LOCATIONS OF PROPERTY OWNERSHIP LINES.

PREPARED FOR
U.S. D.I., BUREAU OF LAND
MANAGEMENT
PRINEVILLE DISTRICT
JAMES HANCOCK, MANAGER
P.O. BOX 550
PRINEVILLE, OREGON 97754
[503] 447-4115


LOCATION SOURCE

U.S.G.S. QUADRANGLES, LIGGETT TABLE, OREG., 7.5 MIN., 1982,
AND ARROWWOOD POINT, OREG., 7.5 MIN., 1982.

LEGEND

 EXISTING RESERVOIR
 DAM * POND
 FENCE
 DRAINAGE
 ROAD
 RIM ROCK
RESERVOIR LOCATION
 LOCATED IN SE 1/4 SE 1/4
 OF SECTION 7, T. 18 S.,
 R. 22 E., W. M., CROOK
 COUNTY, OREGON.
 LOCATED 150 FEET NORTH
 AND 320 FEET WEST OF
 S. E. CORNER OF SEC. 7.
 "HAWK RIM RESERVOIR"

**ARMSTRONG SURVEYING
& ENGINEERING, INC.**
378 EAST SECOND STREET
PRINEVILLE, OREGON 97754
[503] 447-7791

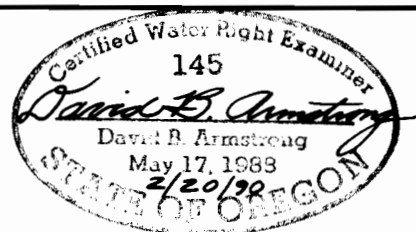

SCALE: 1" = 1320'

DATE: FEB. 14, 1990

W.O. 89-695-C