


T. 1S., R. 12 & 13E., W. M.

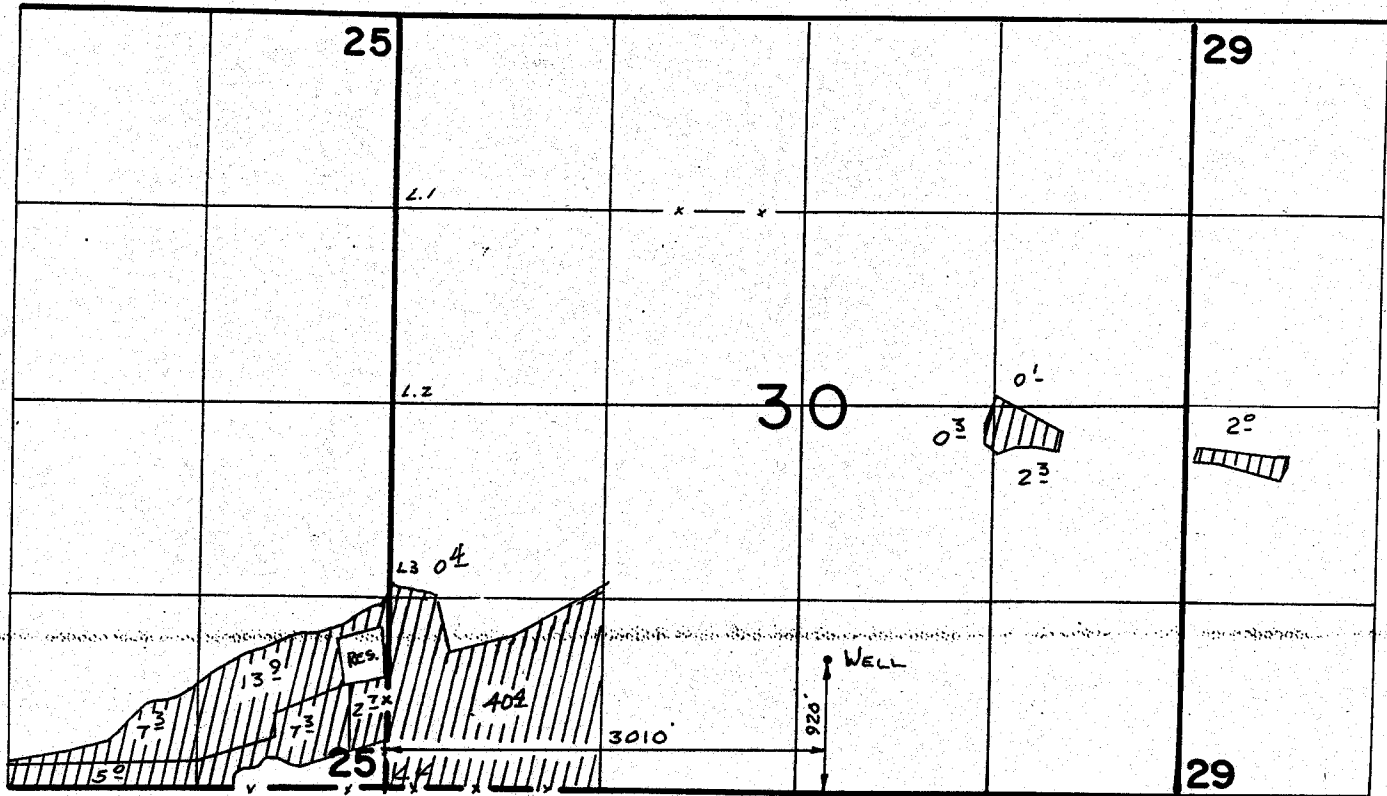

SCALE 1" = 1000'

FINAL PROOF SURVEY
UNDER

Application No. **G:6143**.. Permit No. **G:5820**..
IN NAME OF

MILLER...WHEAT...&...CATTLE, LTD

Surveyed **.S.:12.....** 19**87**., by **V.L. Church**.....