


T. 39 S., R. 8 E., W.M.

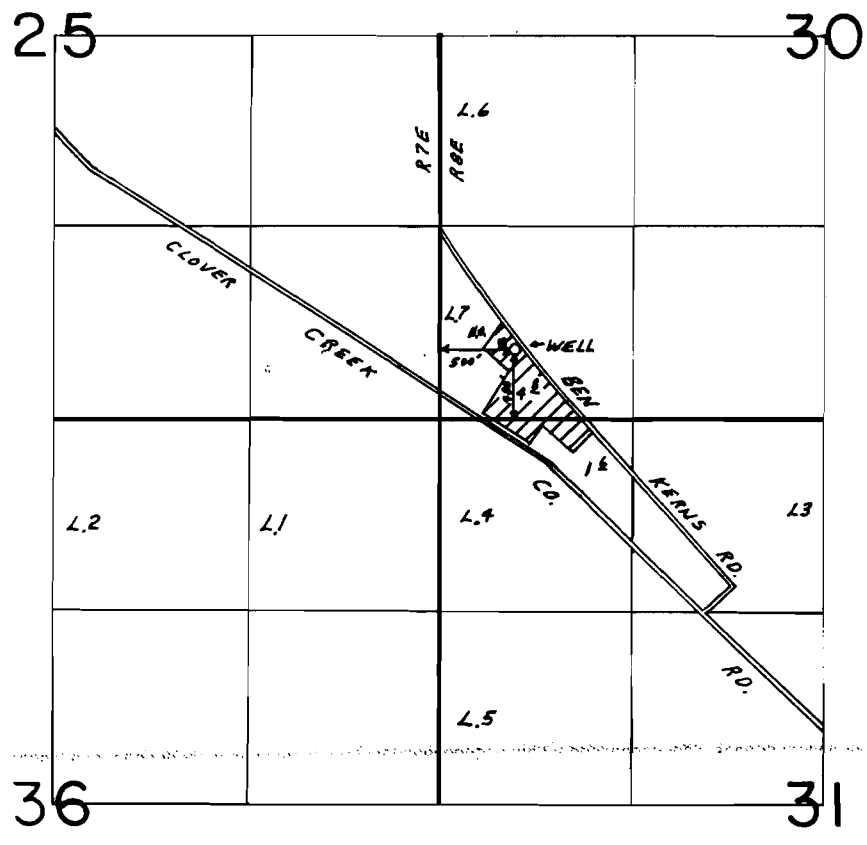

SCALE: 1"=1320'

FINAL PROOF SURVEY UNDER

Application No. G-10317 Permit No. G-9435
 IN NAME OF
RAYMOND E. & DRUCELEIA C. HOBBS
 Surveyed AUG. 20, 1987, by B.S. JAMES

3-6-89