


T7N, RIOW, WM SEC 27

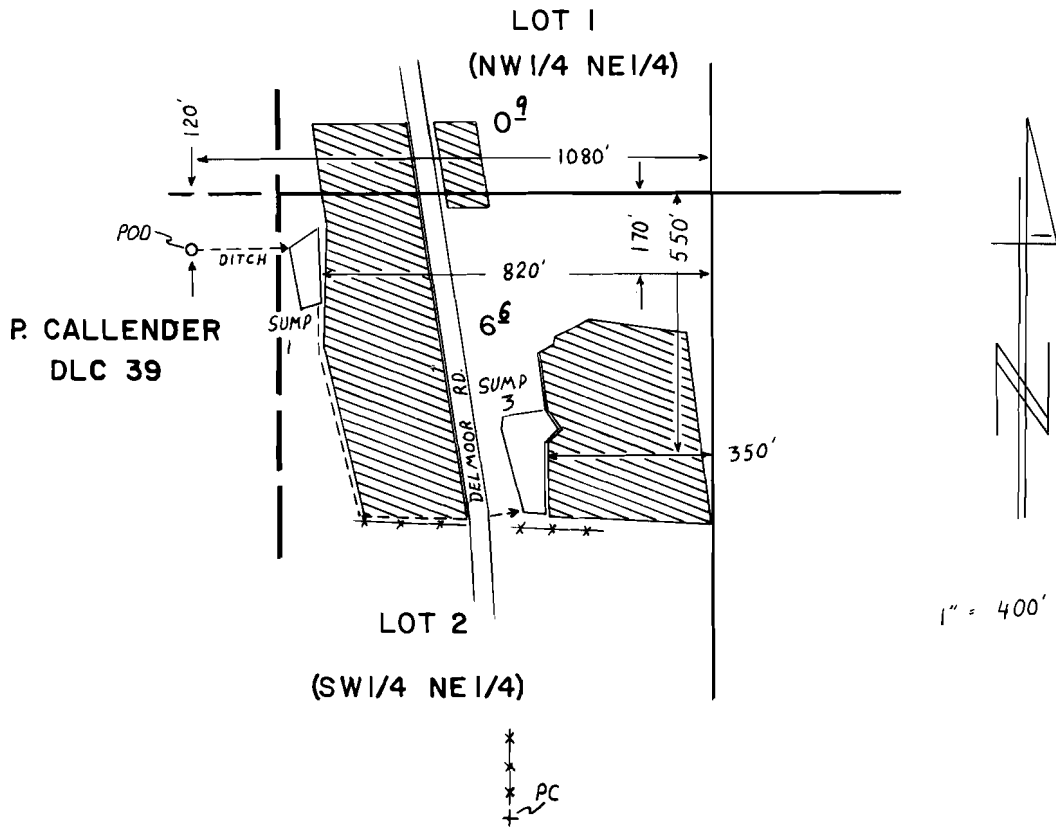

FINAL PROOF SURVEY UNDER

G-10902 G-10045
Application No. 49994 Permit No. 47470
IN NAME OF

RONALD E. KAINO

Surveyed JULY 19 1988, by T.M. WARREN.

RWK
PTS WFF